

LOT'S 8-9-10 BLK. 86.


WEST ST. PAUL PROPER.

JOHN B. IAYINE, SURVEYOR.

ST. PAUL MINN.

Scale 20ft. per inch.

JULY 16-08.

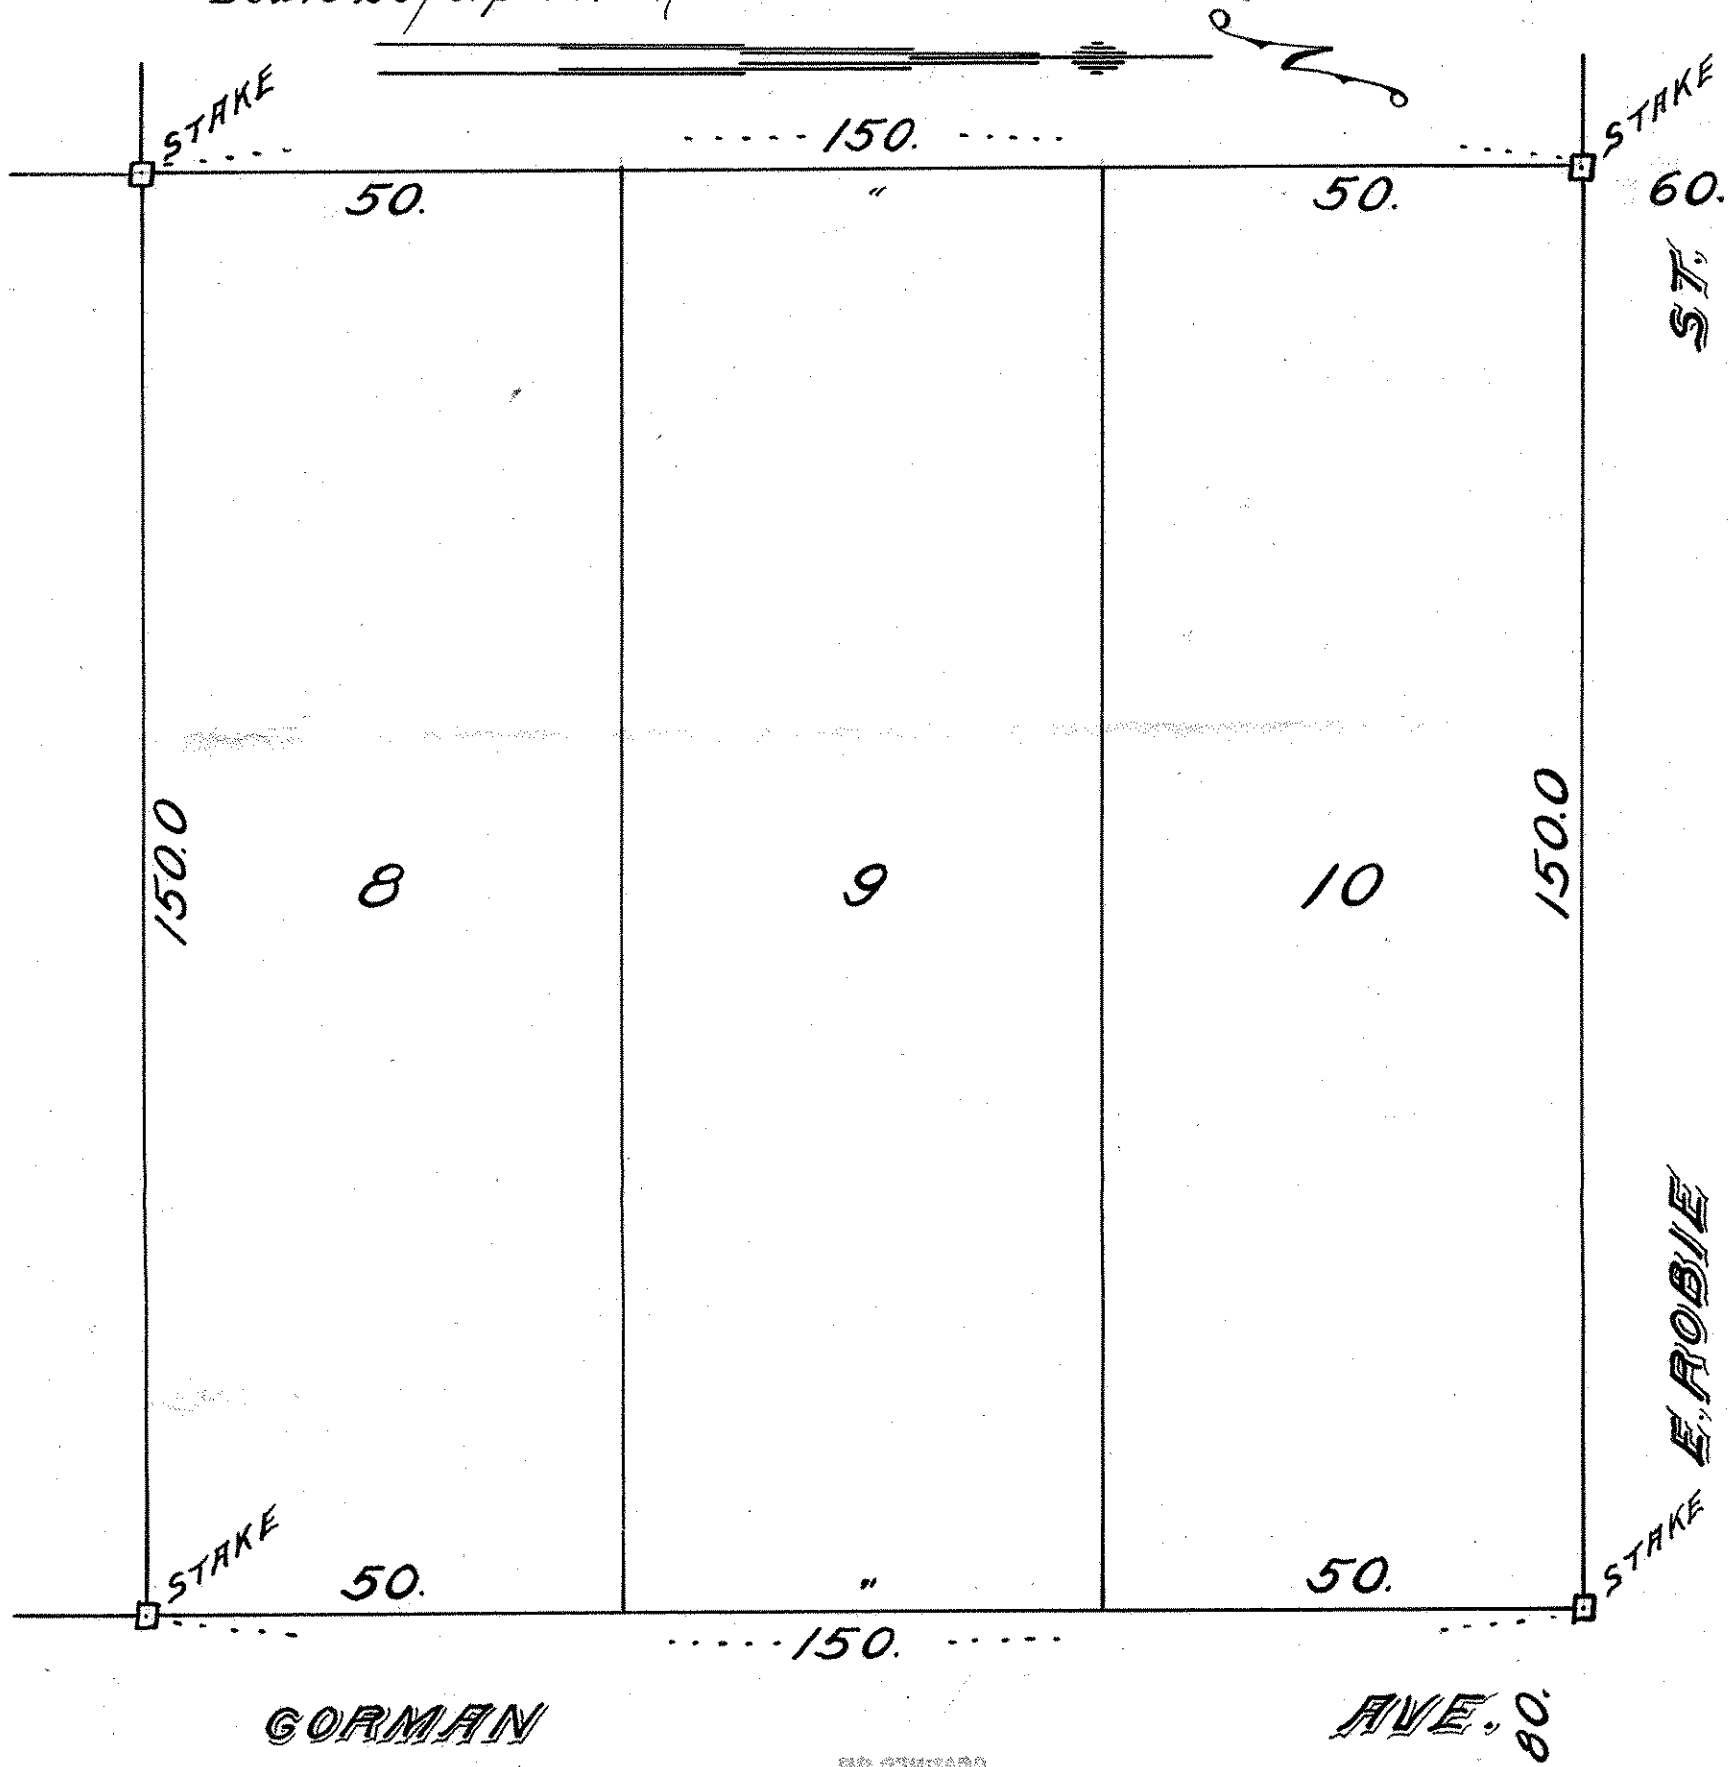

GORMAN

AVE. 80.

NO CHANGE