


LOT 2 BLOCK 90
WEST ST. PAUL PROPER.

John B. Irvine, Surveyor.

June 17-1919.

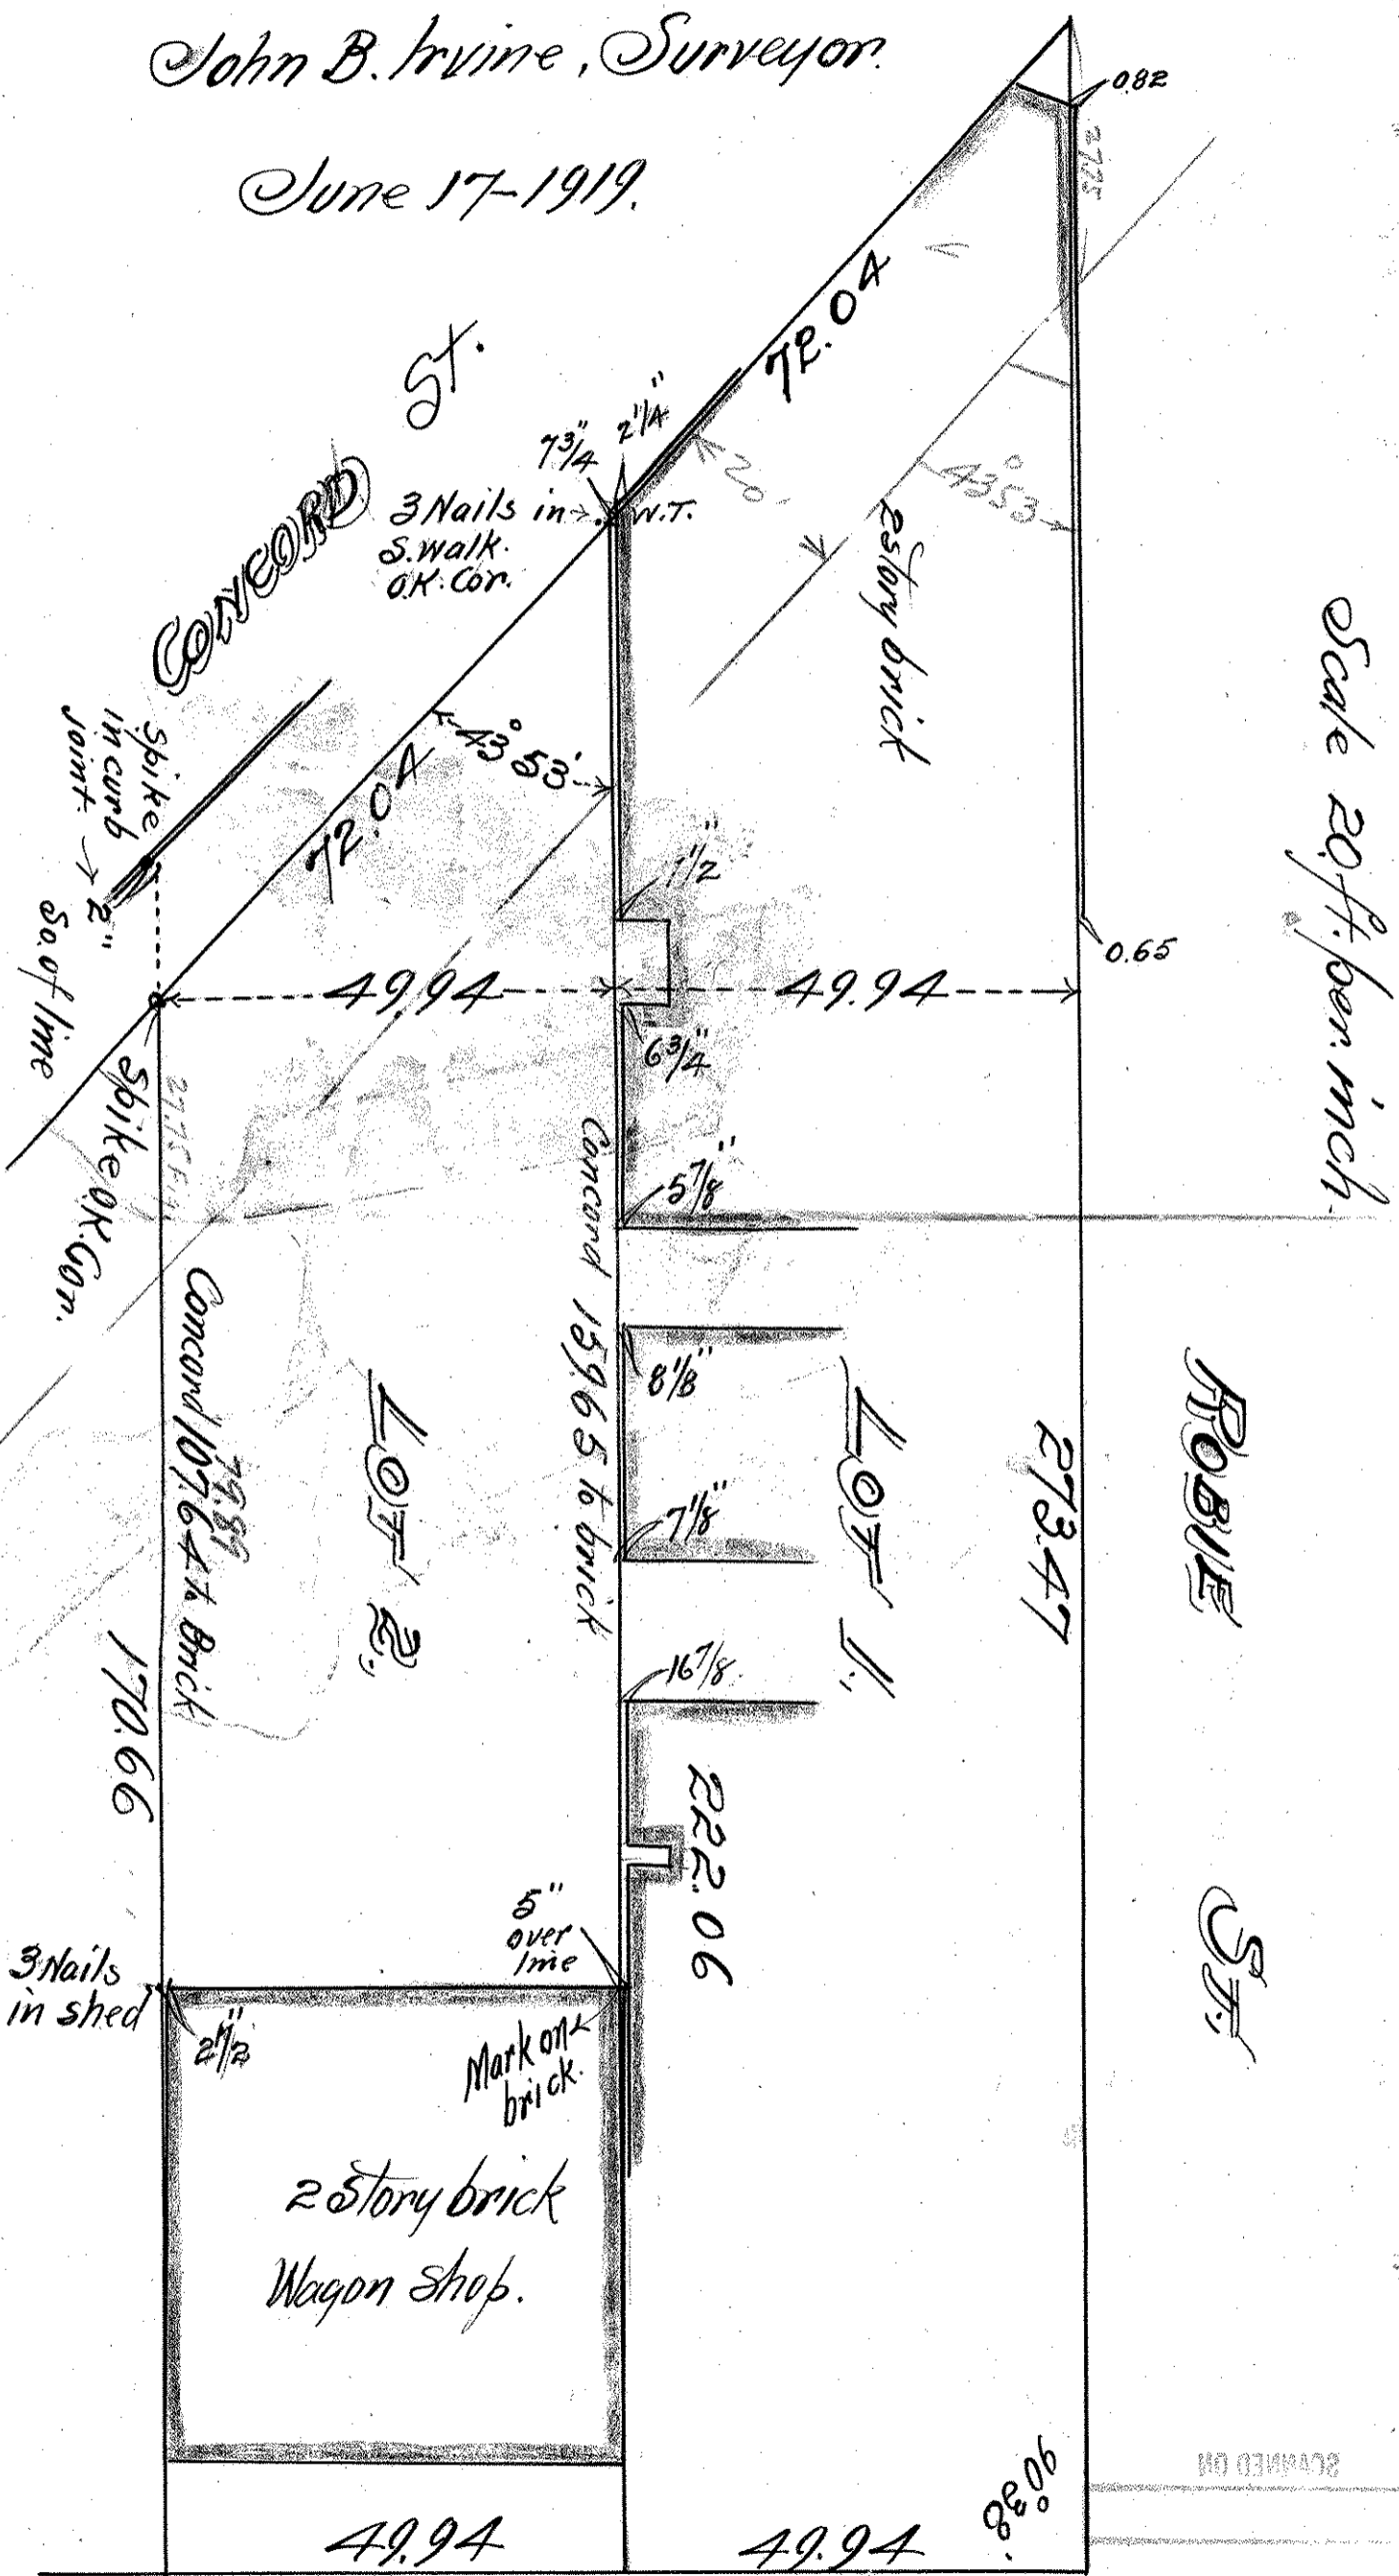

GREENWOOD AVE.

SCANNED ON