

THE MIDDLE  $\frac{1}{3}$  OF LOTS 485 &  
THE MIDDLE  $\frac{1}{3}$  OF SOUTH  $\frac{1}{2}$  LOT 38  
THE EAST  $\frac{1}{3}$  OF LOTS 485 &  
THE EAST  $\frac{1}{3}$  OF SOUTH  $\frac{1}{2}$  LOT 3.

BLOCK 95.


WEST ST. PAUL PROPER.

John B. Irvine, Surveyor.

MAY 19-1920.

Scale 20 ft. per inch.

LIVINGSTON AVE.

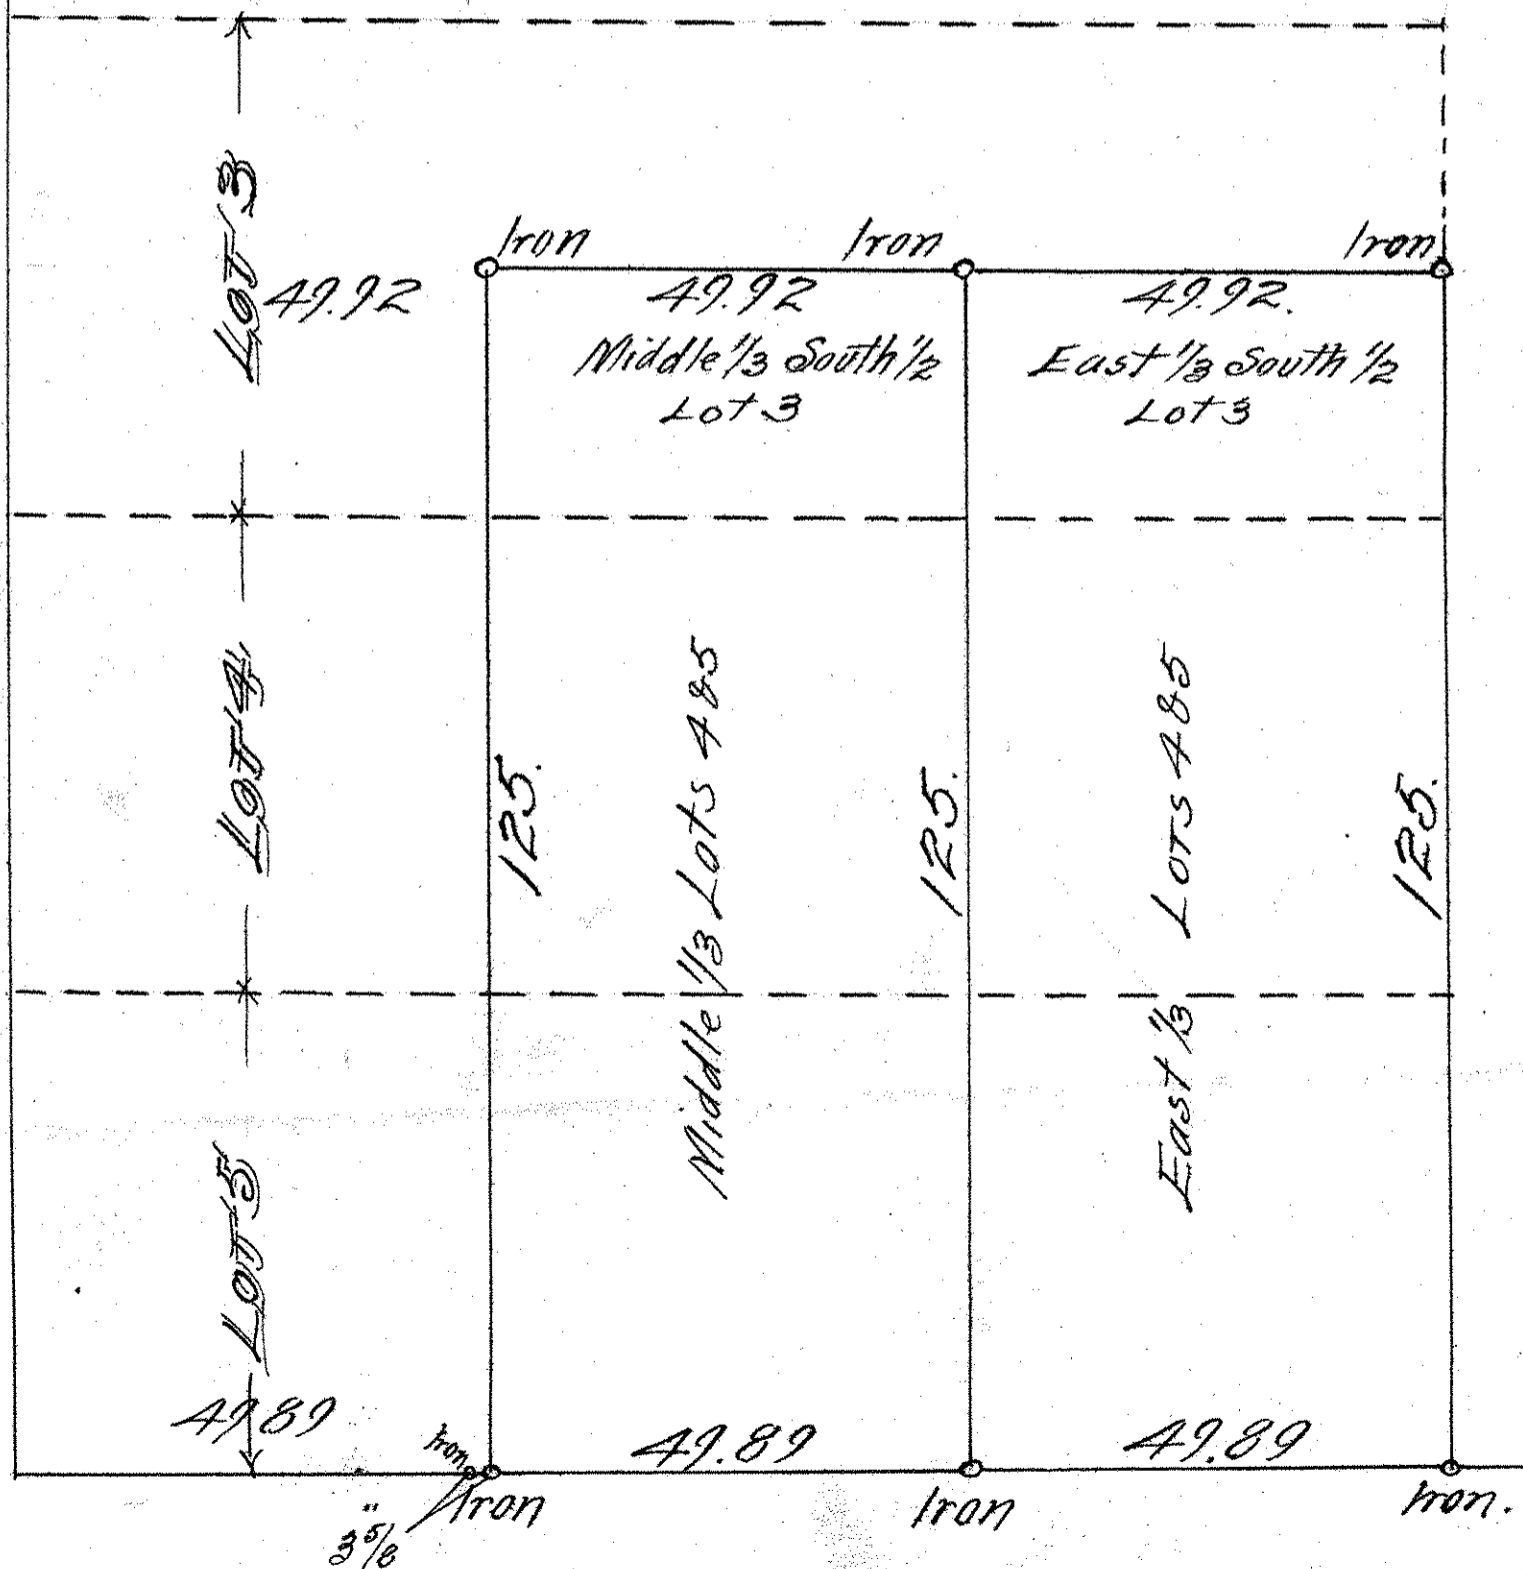

DEARBORN ST.