


E. 1/2 OF LOTS 1 & 2 BLOCK 126
WEST ST. PAUL PROPER.
No. 9'04. Moritz Heim 10' = 1"
ELIZABETH ST.

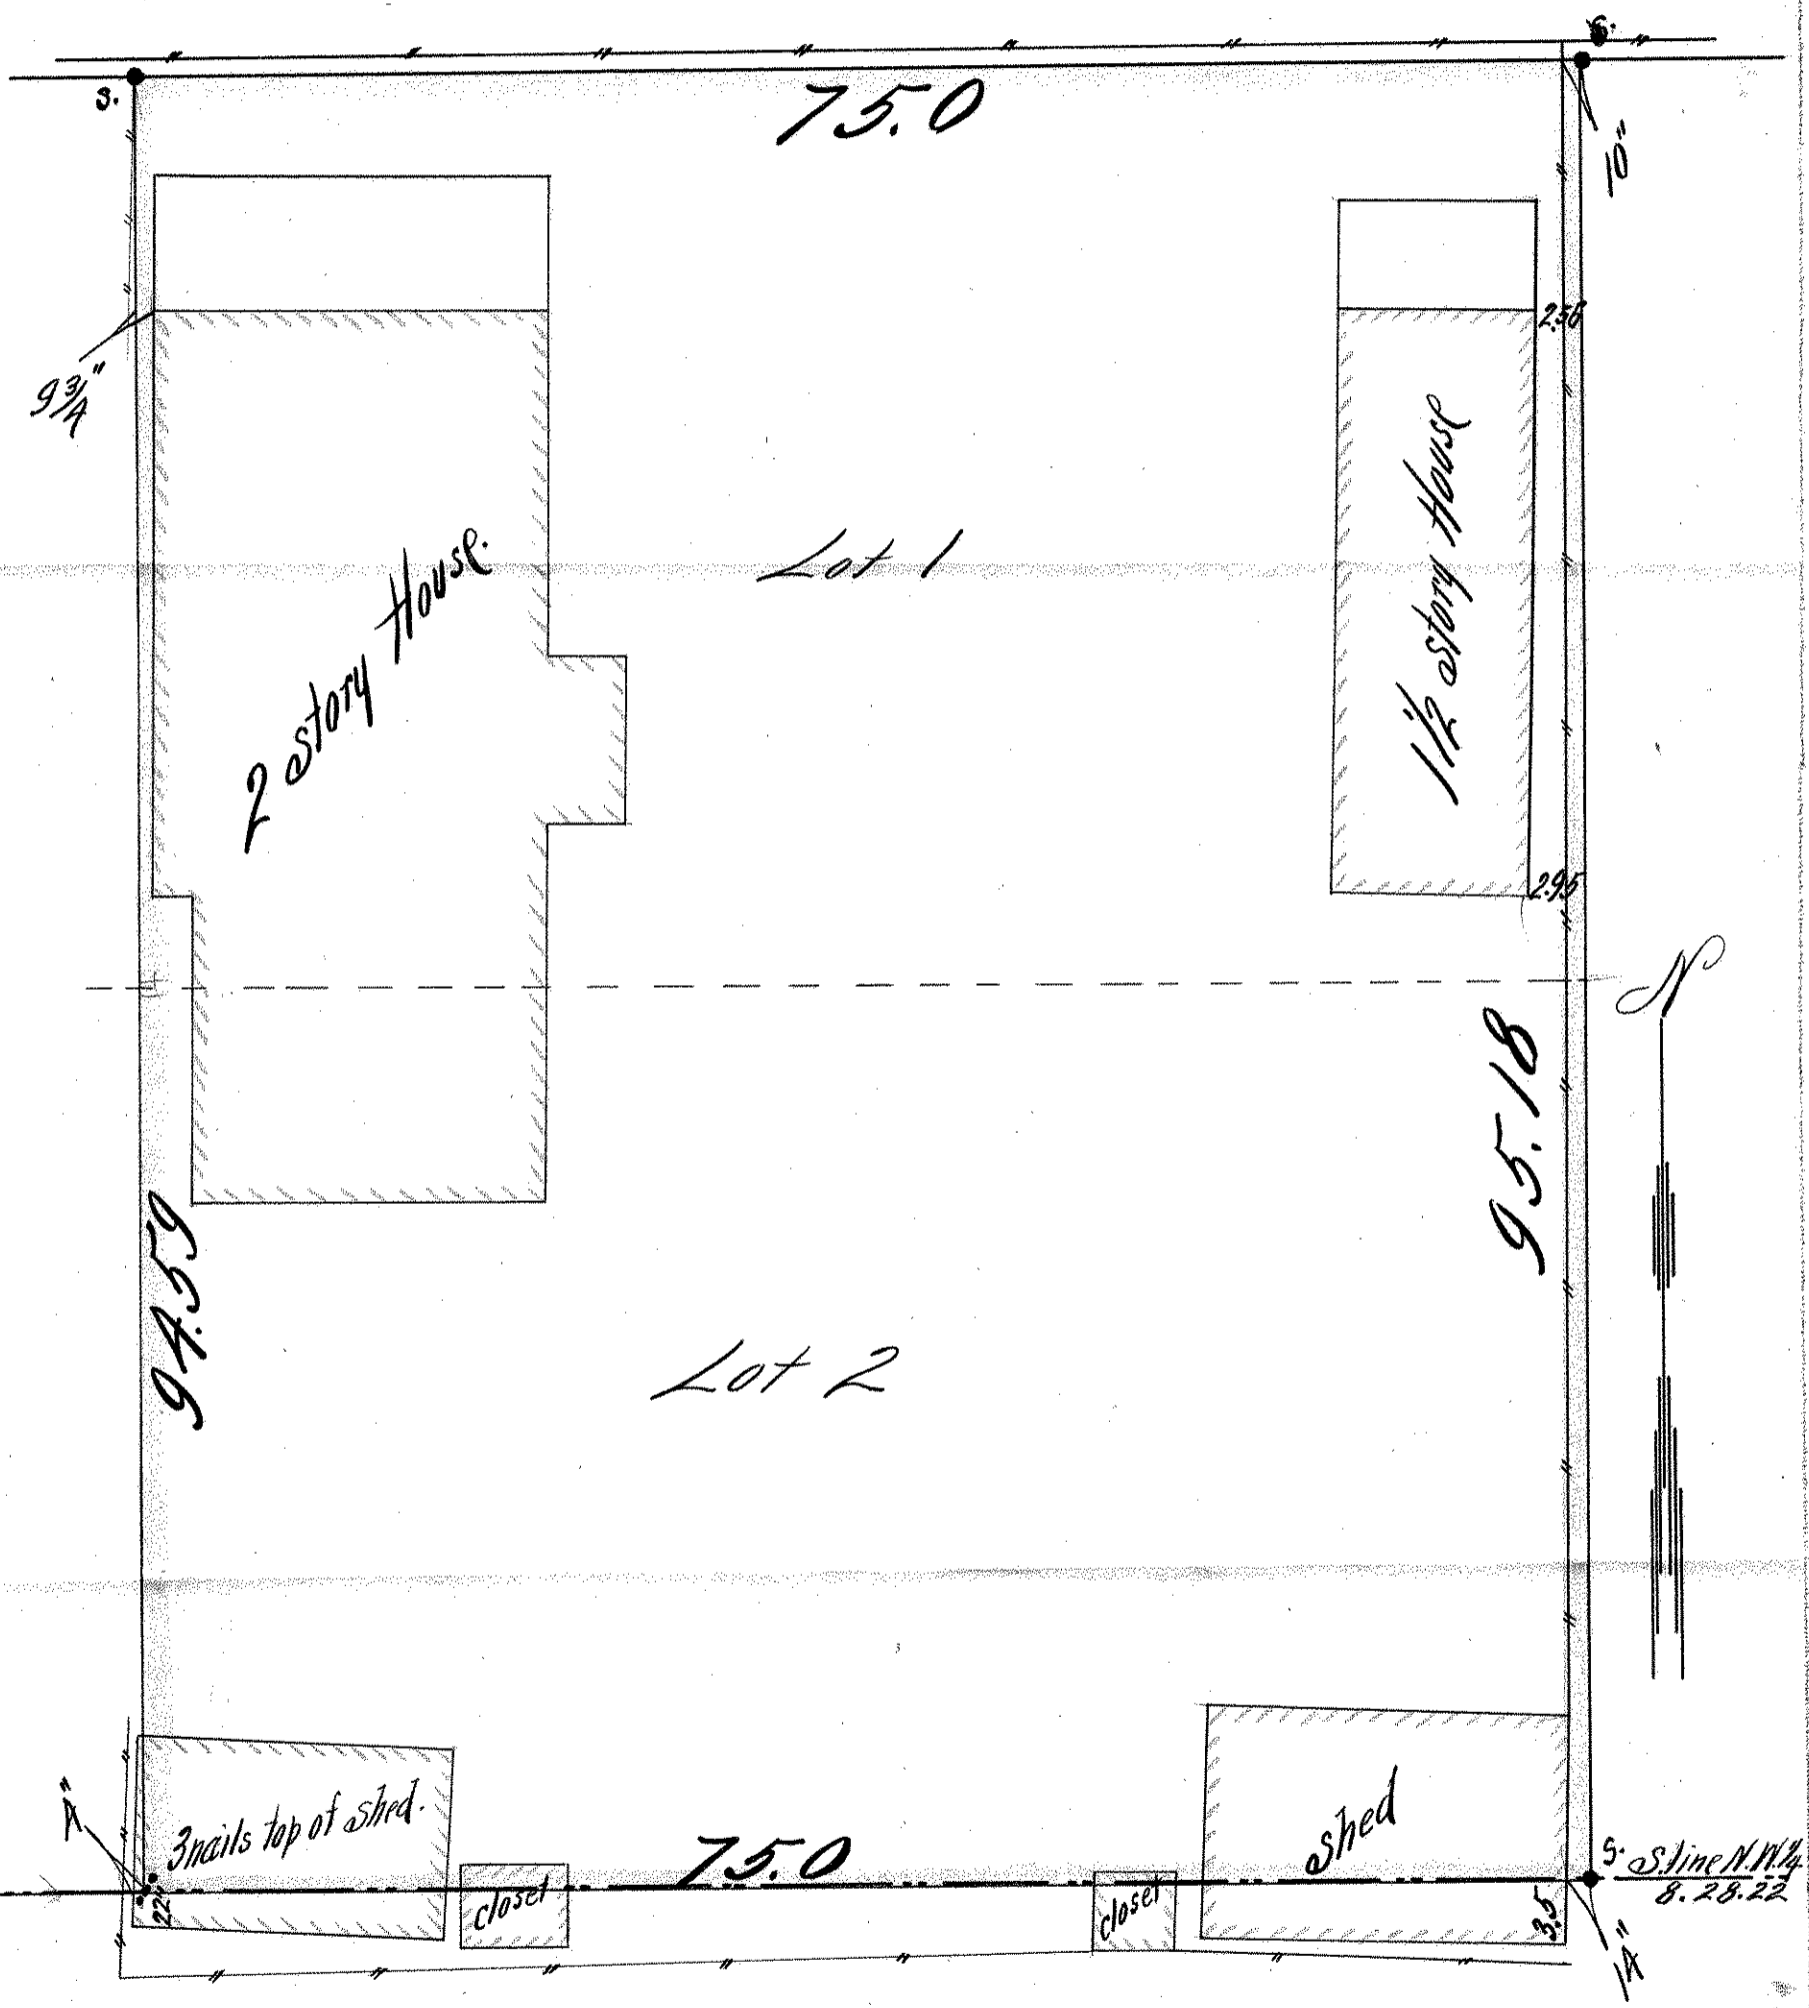

SCANNED ON

