


LOTS 4 & 5 BLOCK 125
WEST ST. PAUL PROPER
scale 20 feet per inch
Houses Located June 21st 1902.

LIVINGSTON AVE. 80

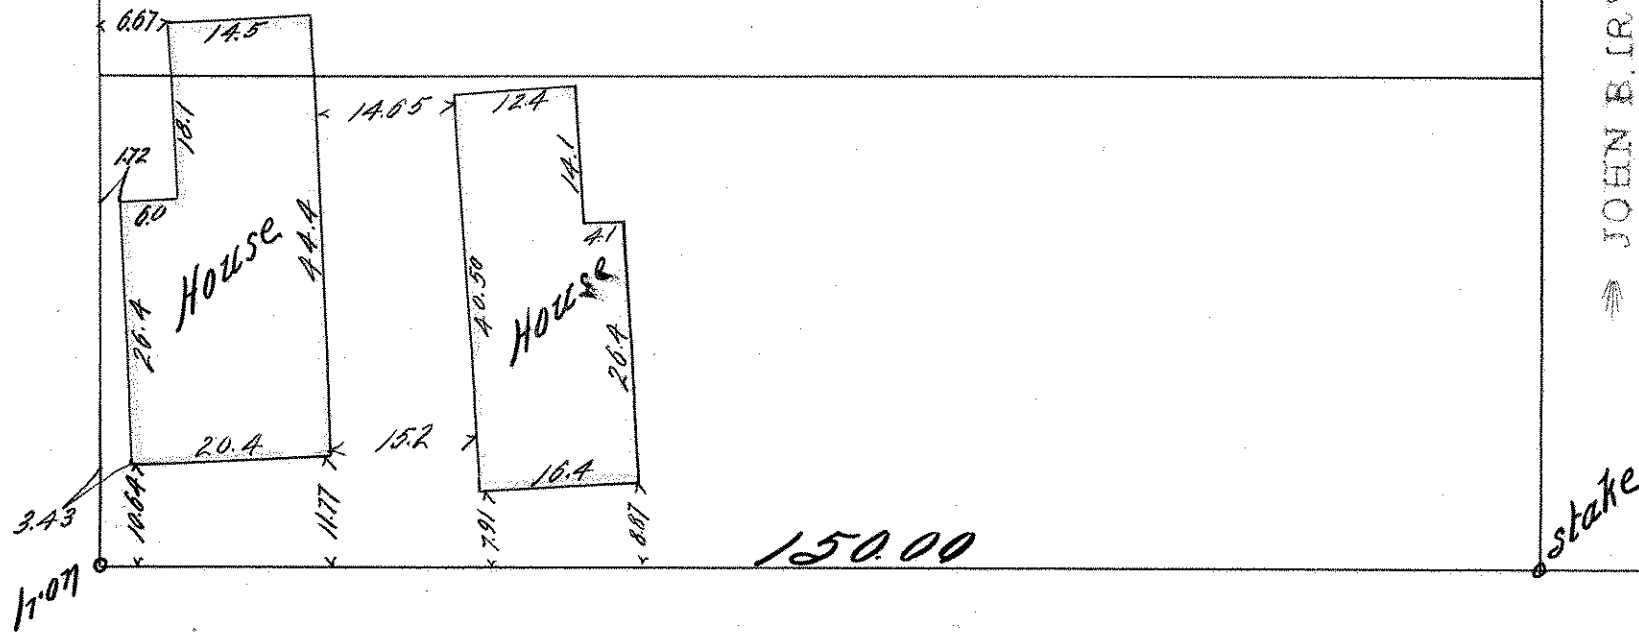

JOHN B. IRVINE
Co. Surveyor, R. 16, County Heav.

AUGUSTA ST. 60

B. 47 P. 29