

W'ly 55 ft. of the E'ly 105 ft.

LOTS 1 & 2 BLOCK 113

WEST ST. PAUL PROPER,


JOHN B. IRVINE, SURVEYOR.

408 GLOBE BLDG.

ST. PAUL, MINN.

AUG. 10-1914

scale 20 ft. per inch.

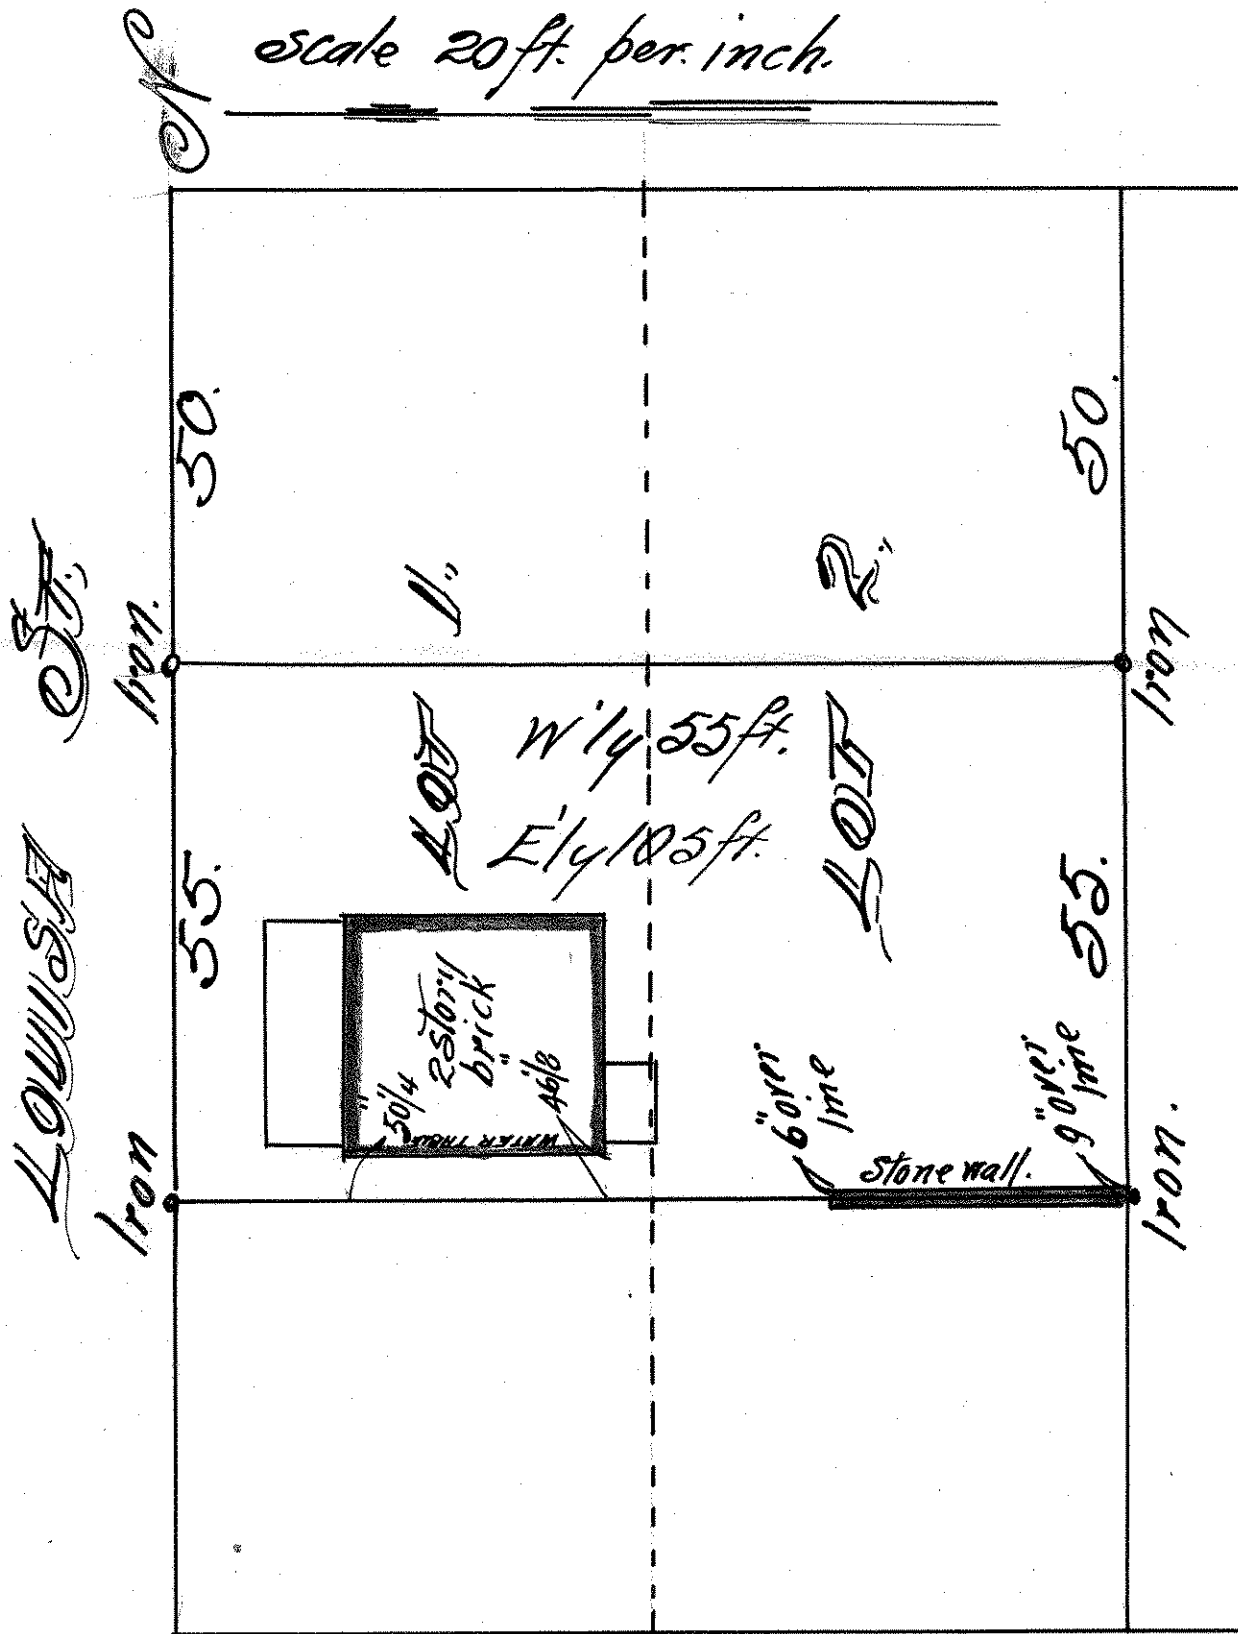

GORMAIN AVE.

