


JOHN B. IRVINE, SURVEYOR.

408 GLOBE BLDG.

ST. PAUL, MINN.

DEC. 2, 1914.

Scale 20ft. per inch.

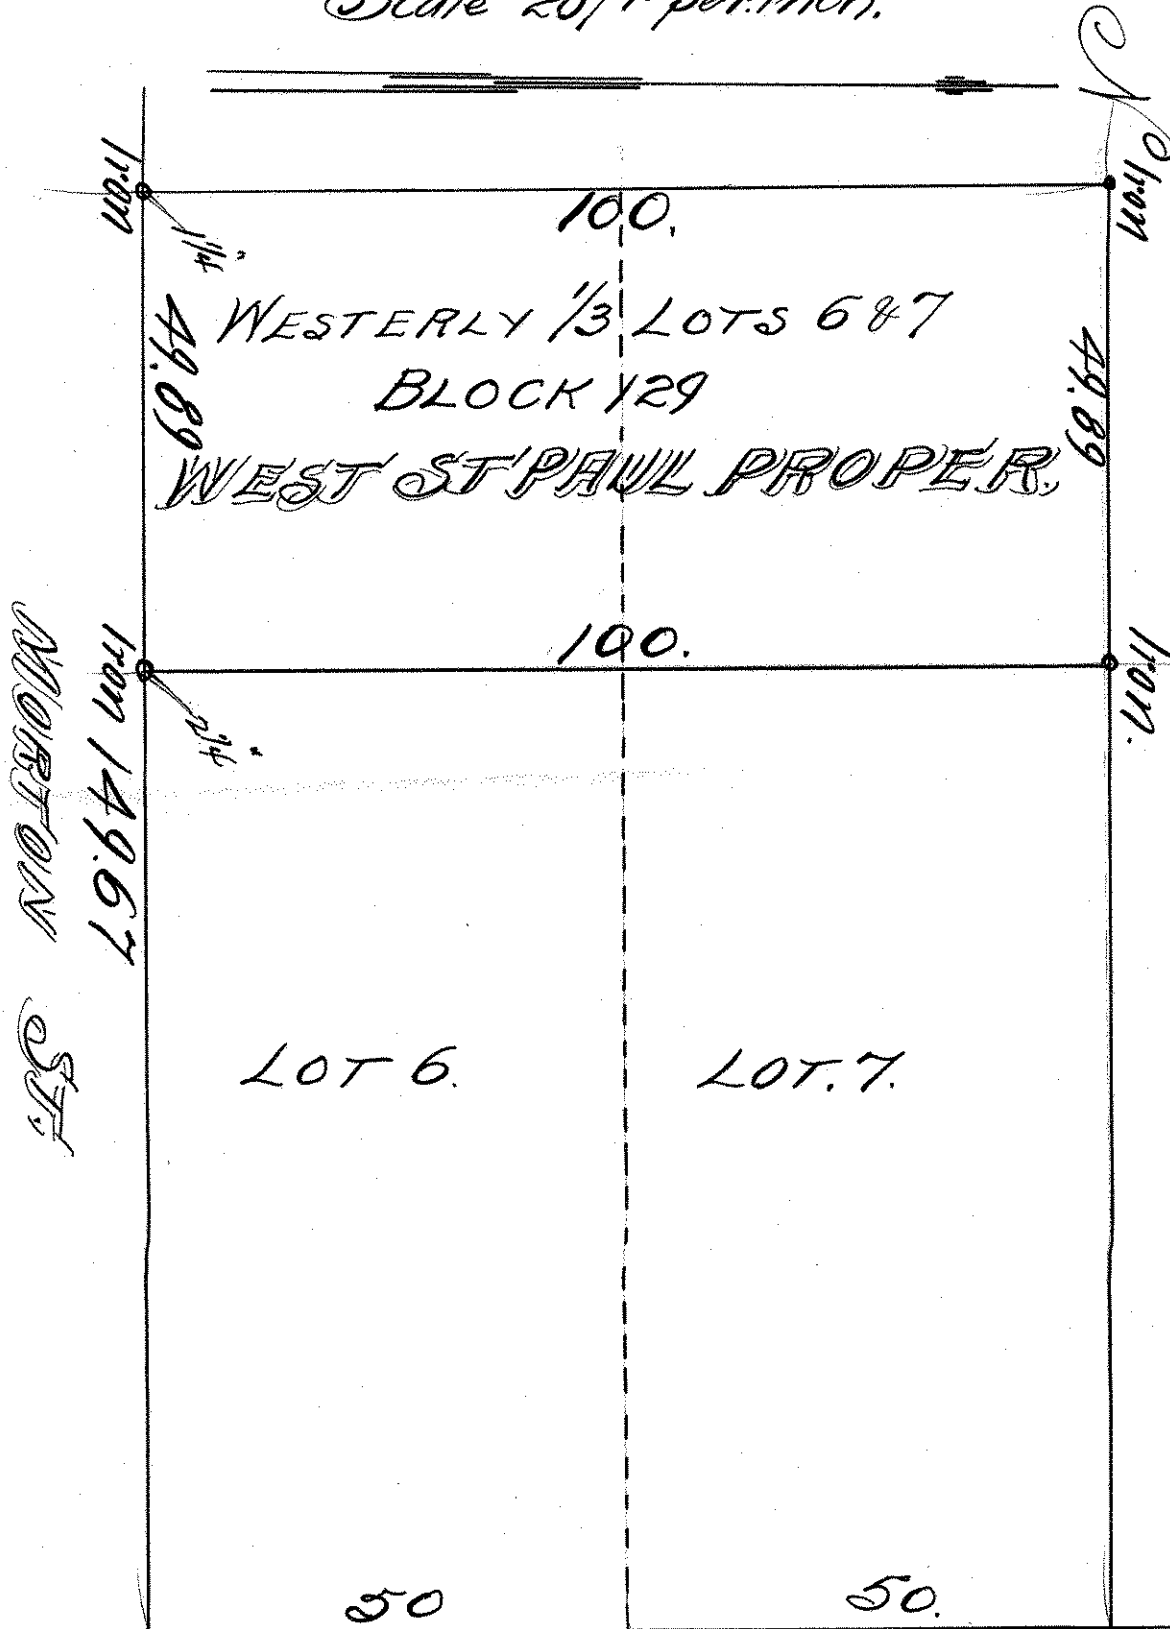

RECORDED

LIVINGSTON AVE.