

LOT 1 & NORTH 1/2 LOT 2

EXCEPT SOUTH WABASHA ST.

BLOCK 133

WEST ST. PAUL PROPER.


JOHN B. IRVINE, SURVEYOR.

408 GLOBE BLDG.

ST. PAUL, MINN.

JUNE 26-1914.

scale 20 ft. per inch.

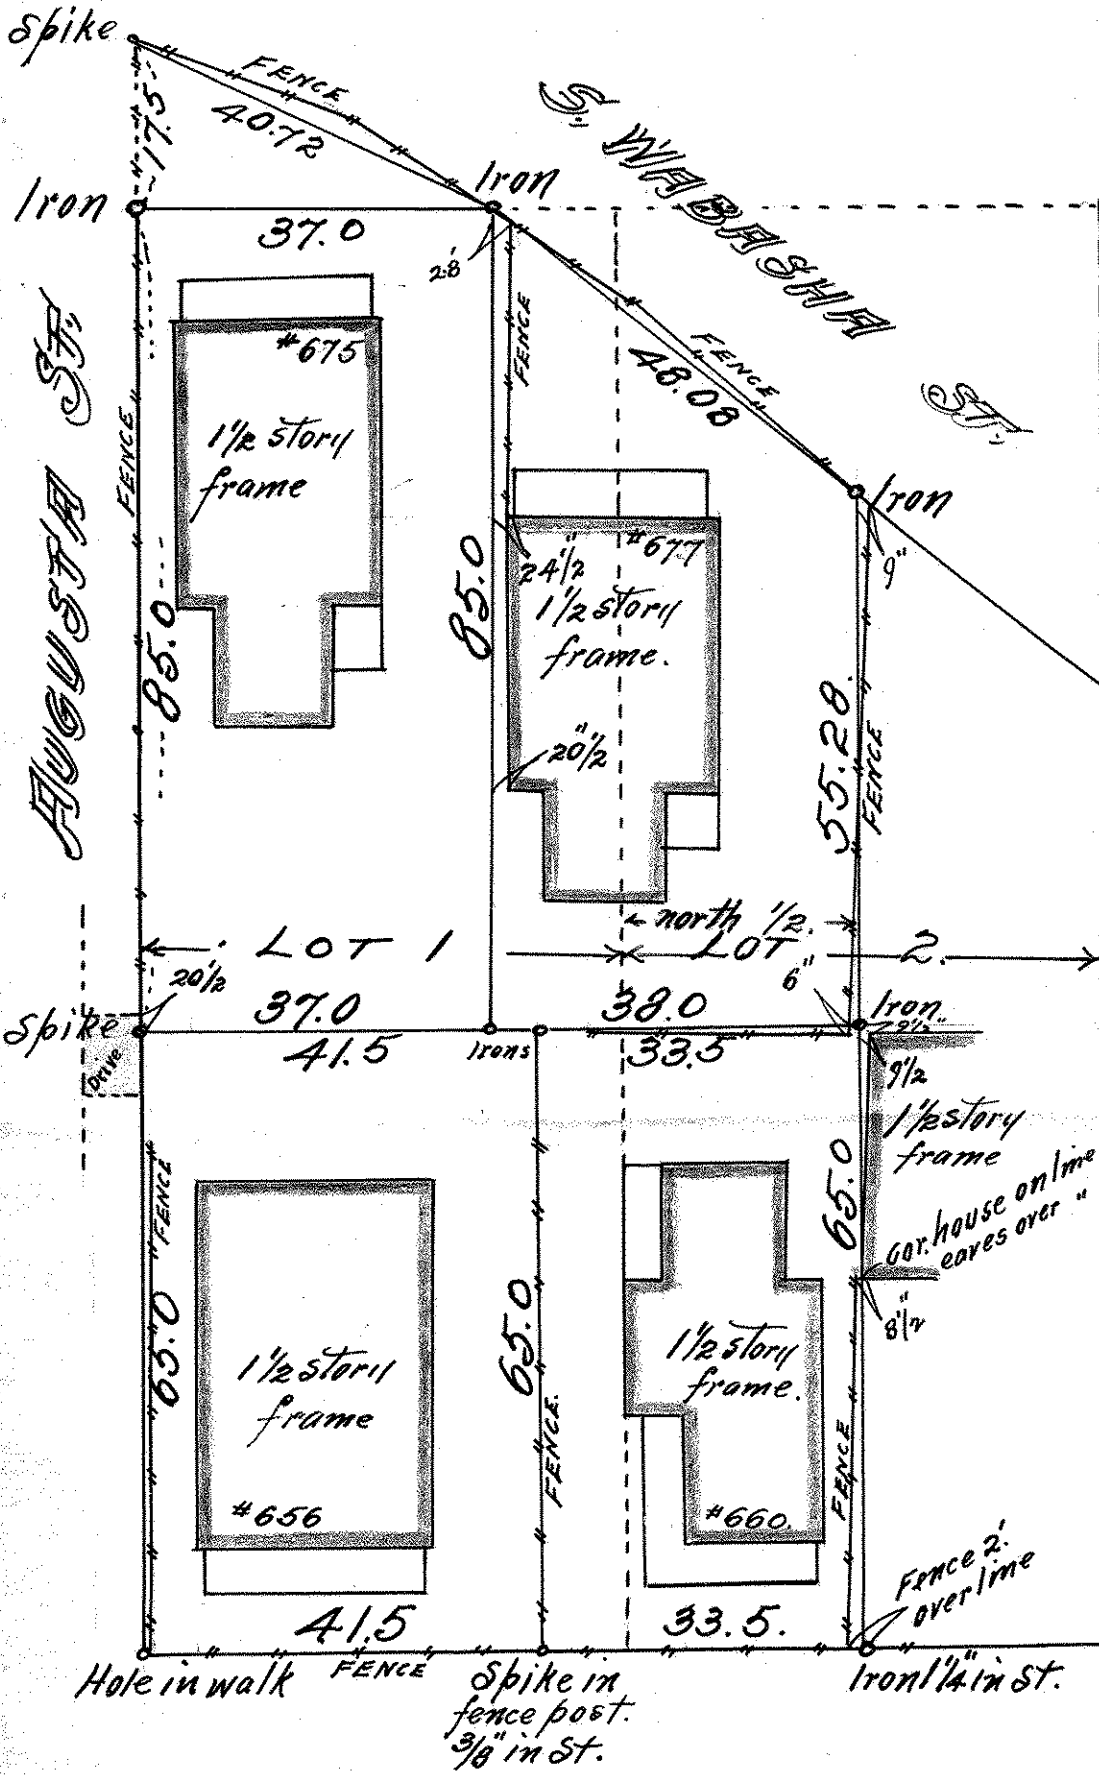

WINSLOW AVE.

NO. 133