


LOTS 1 & 2 BLOCK 148
WEST ST PAUL PROPER.

JOHN B. IRVINE SURVEYOR.
ROOM 406. GLOBE BLDG.
ST PAUL MINN.

SCALE 1 IN. = 20 FT.

MARCH 24-06.

PAGE 57.

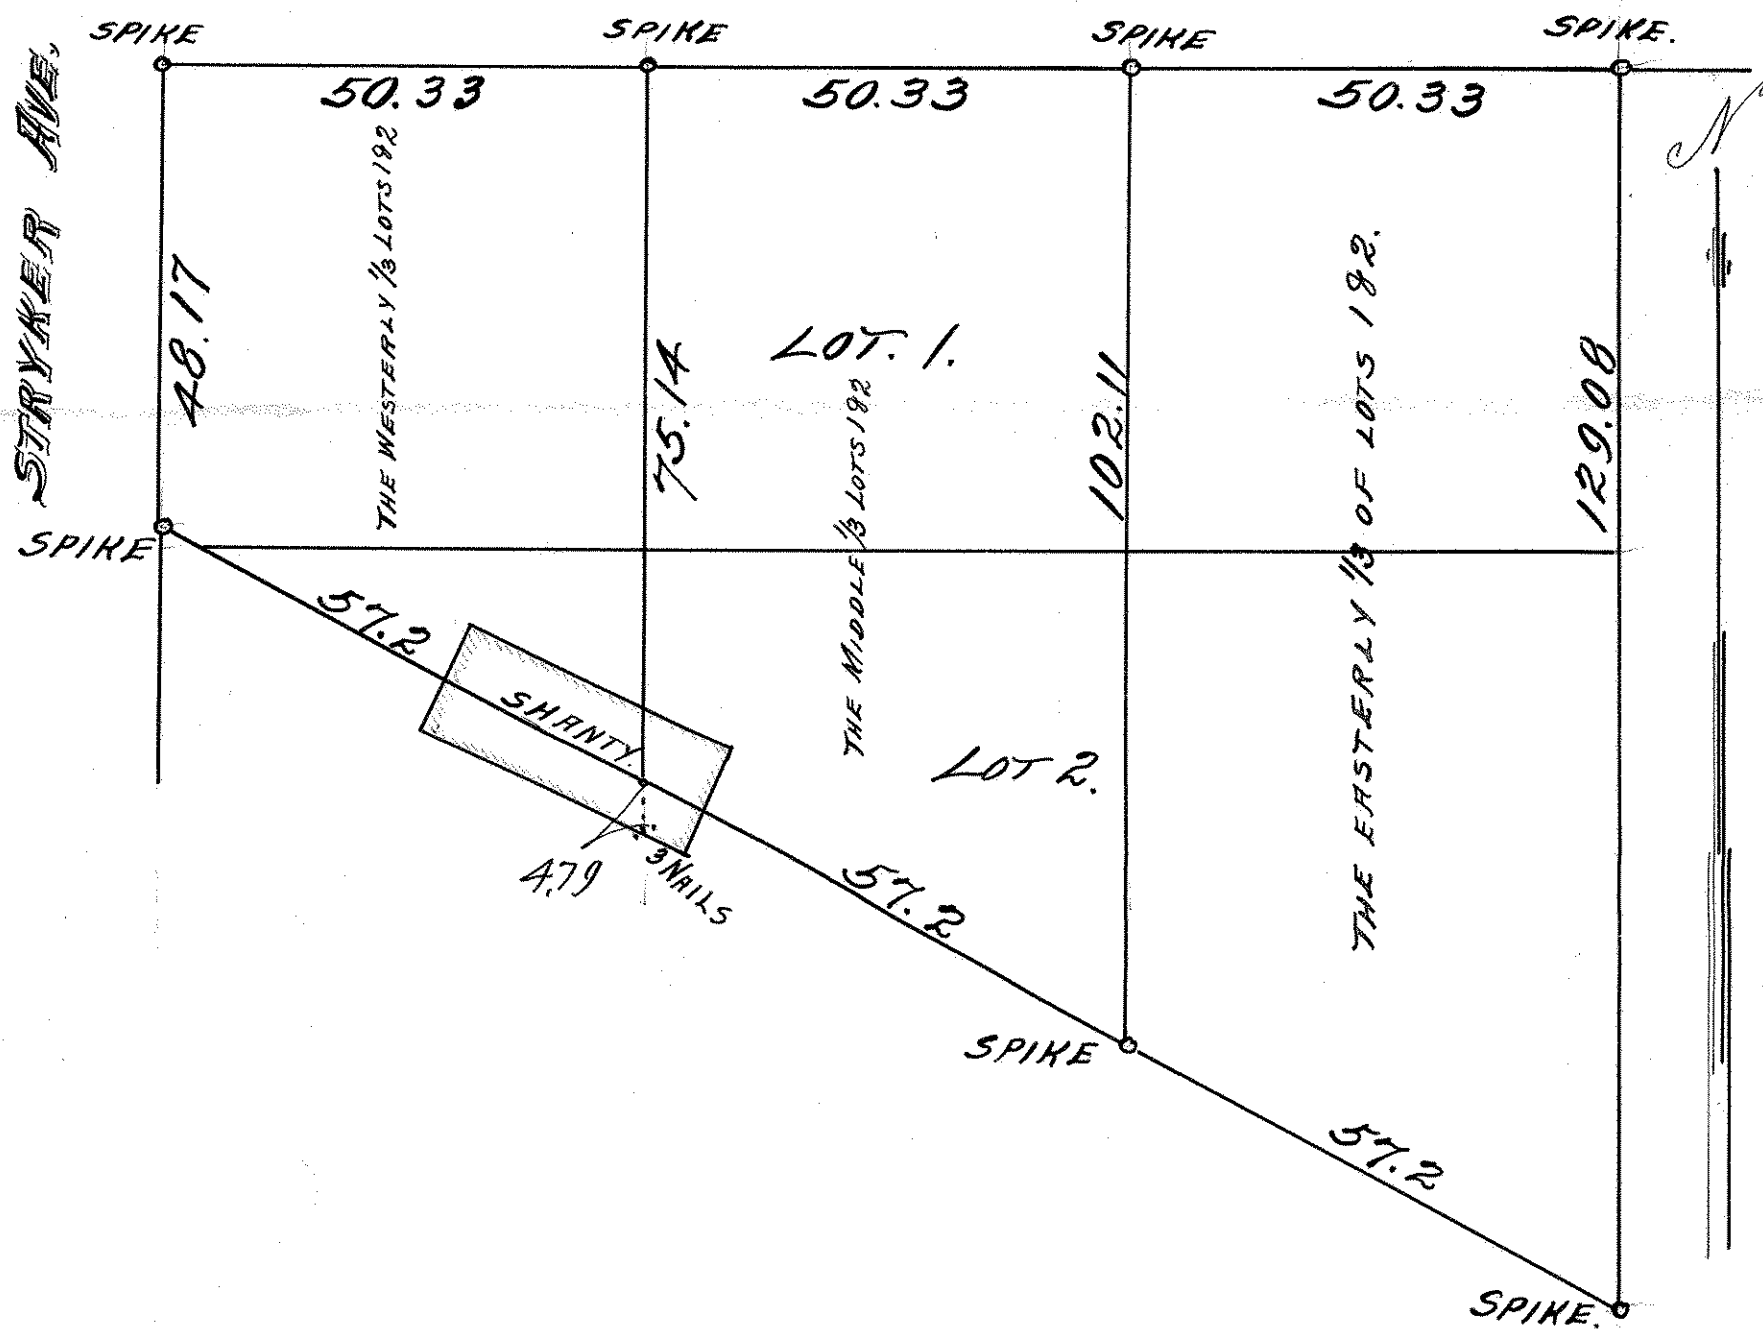

NO CHANGE

