


LOT 10 BLOCK 151
WEST ST. PAUL
PROPER.

JOHN B. IRVINE, SURVEYOR.
408 GLOBE BLDG.
ST PAUL MINN.
APRIL 2. - 1909.
SCALE 20 ft. per inch.

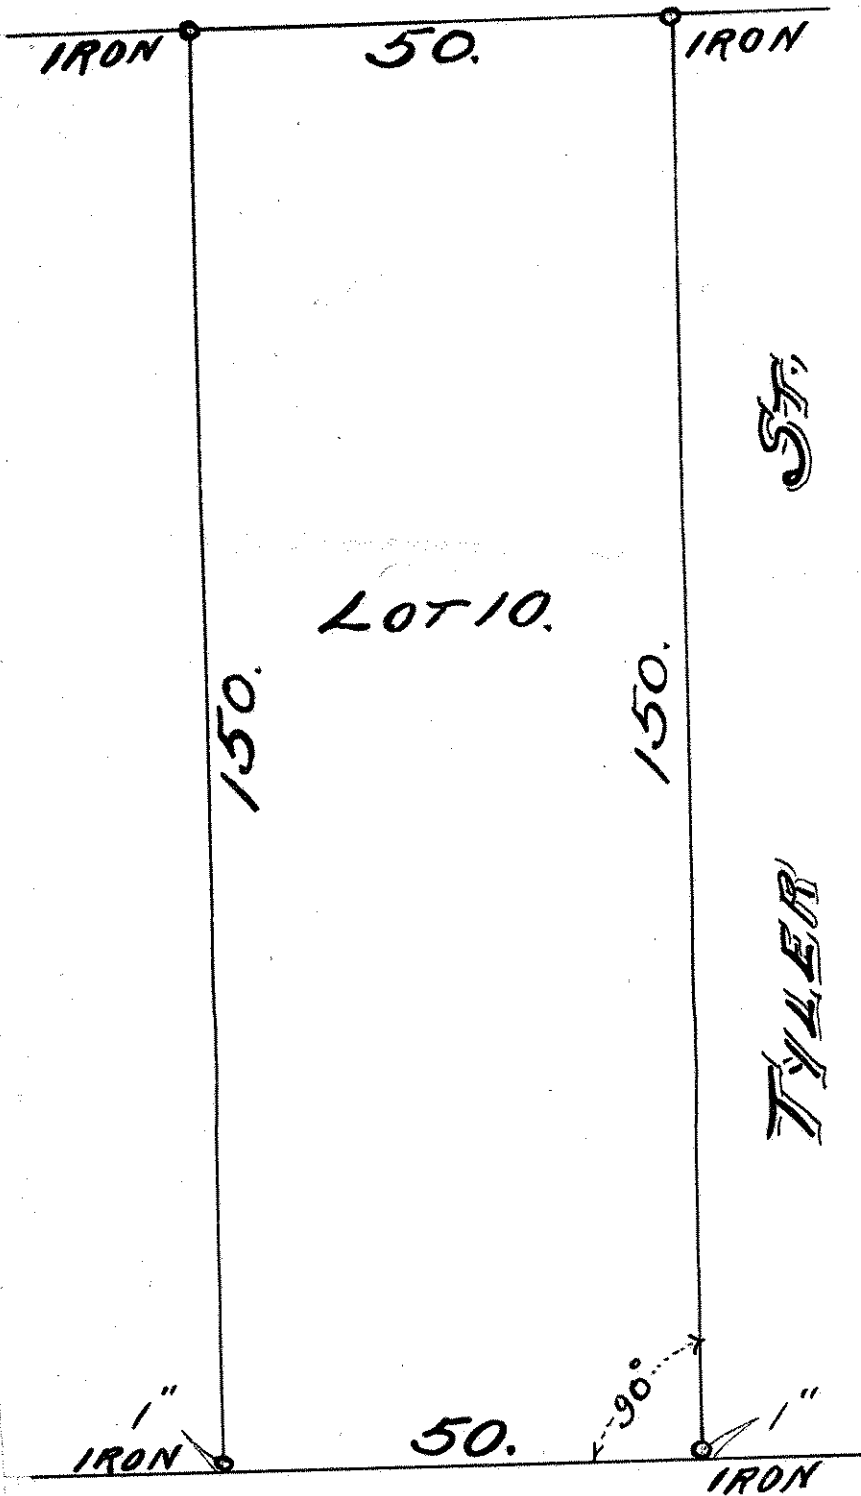

SO ROBERT ST. N