


WHARTON BLAIR & MILLER'S
REAR BLOCK 1 BALD EAGLE LAKE

JOHN B. IRVINE, SURVEYOR.
MARCH 26-1910.

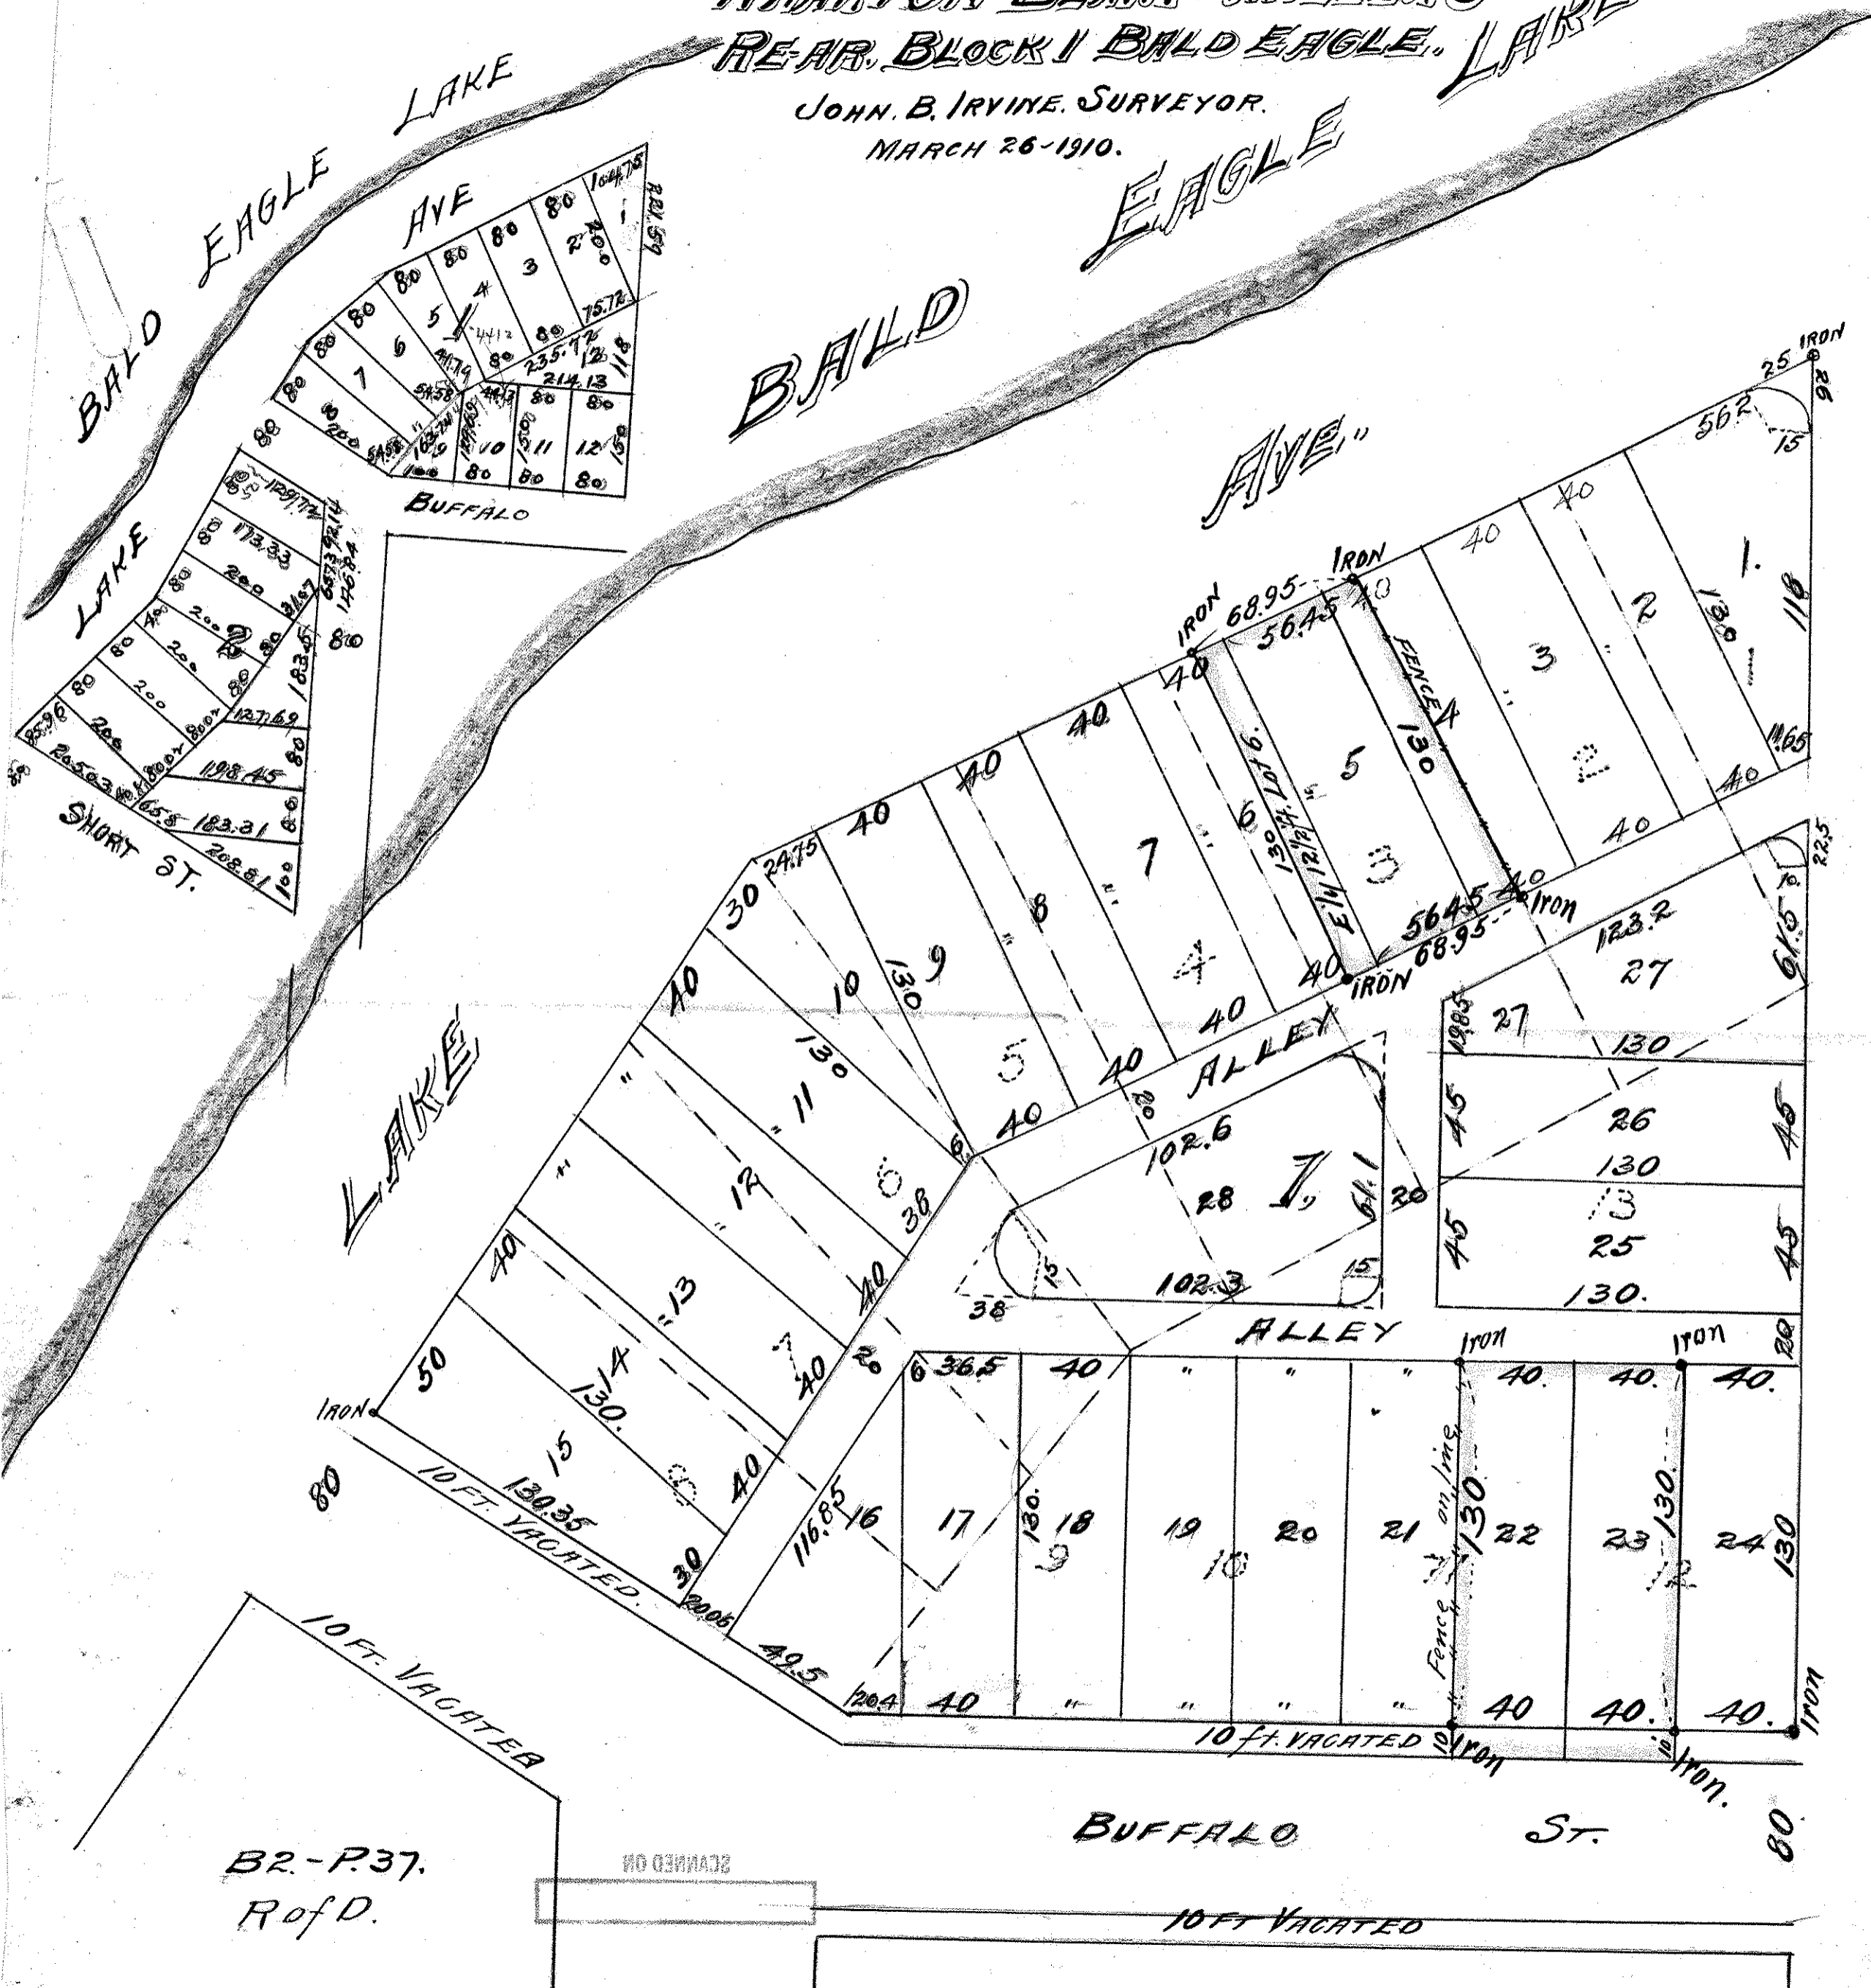

SCALE 80 feet per inch

ADD

SHADY SIDE

B2-P.37.
R of D.

SCANNED ON

10 FT VACATED