

PLAT OF SURVEY  
 WHARTON, BLAIR AND MILLERS  
 RE-AR. OF BLK-1 OF BALDEAGLE  
 RAMSEY COUNTY, MINN.

December, 17, 1930 Scale - 1" = 25'



*P.R. Panioto*

Consulting Engineer

69 Seventh Ave. N.E.

North St. Paul, Minn.

SCANNED ON

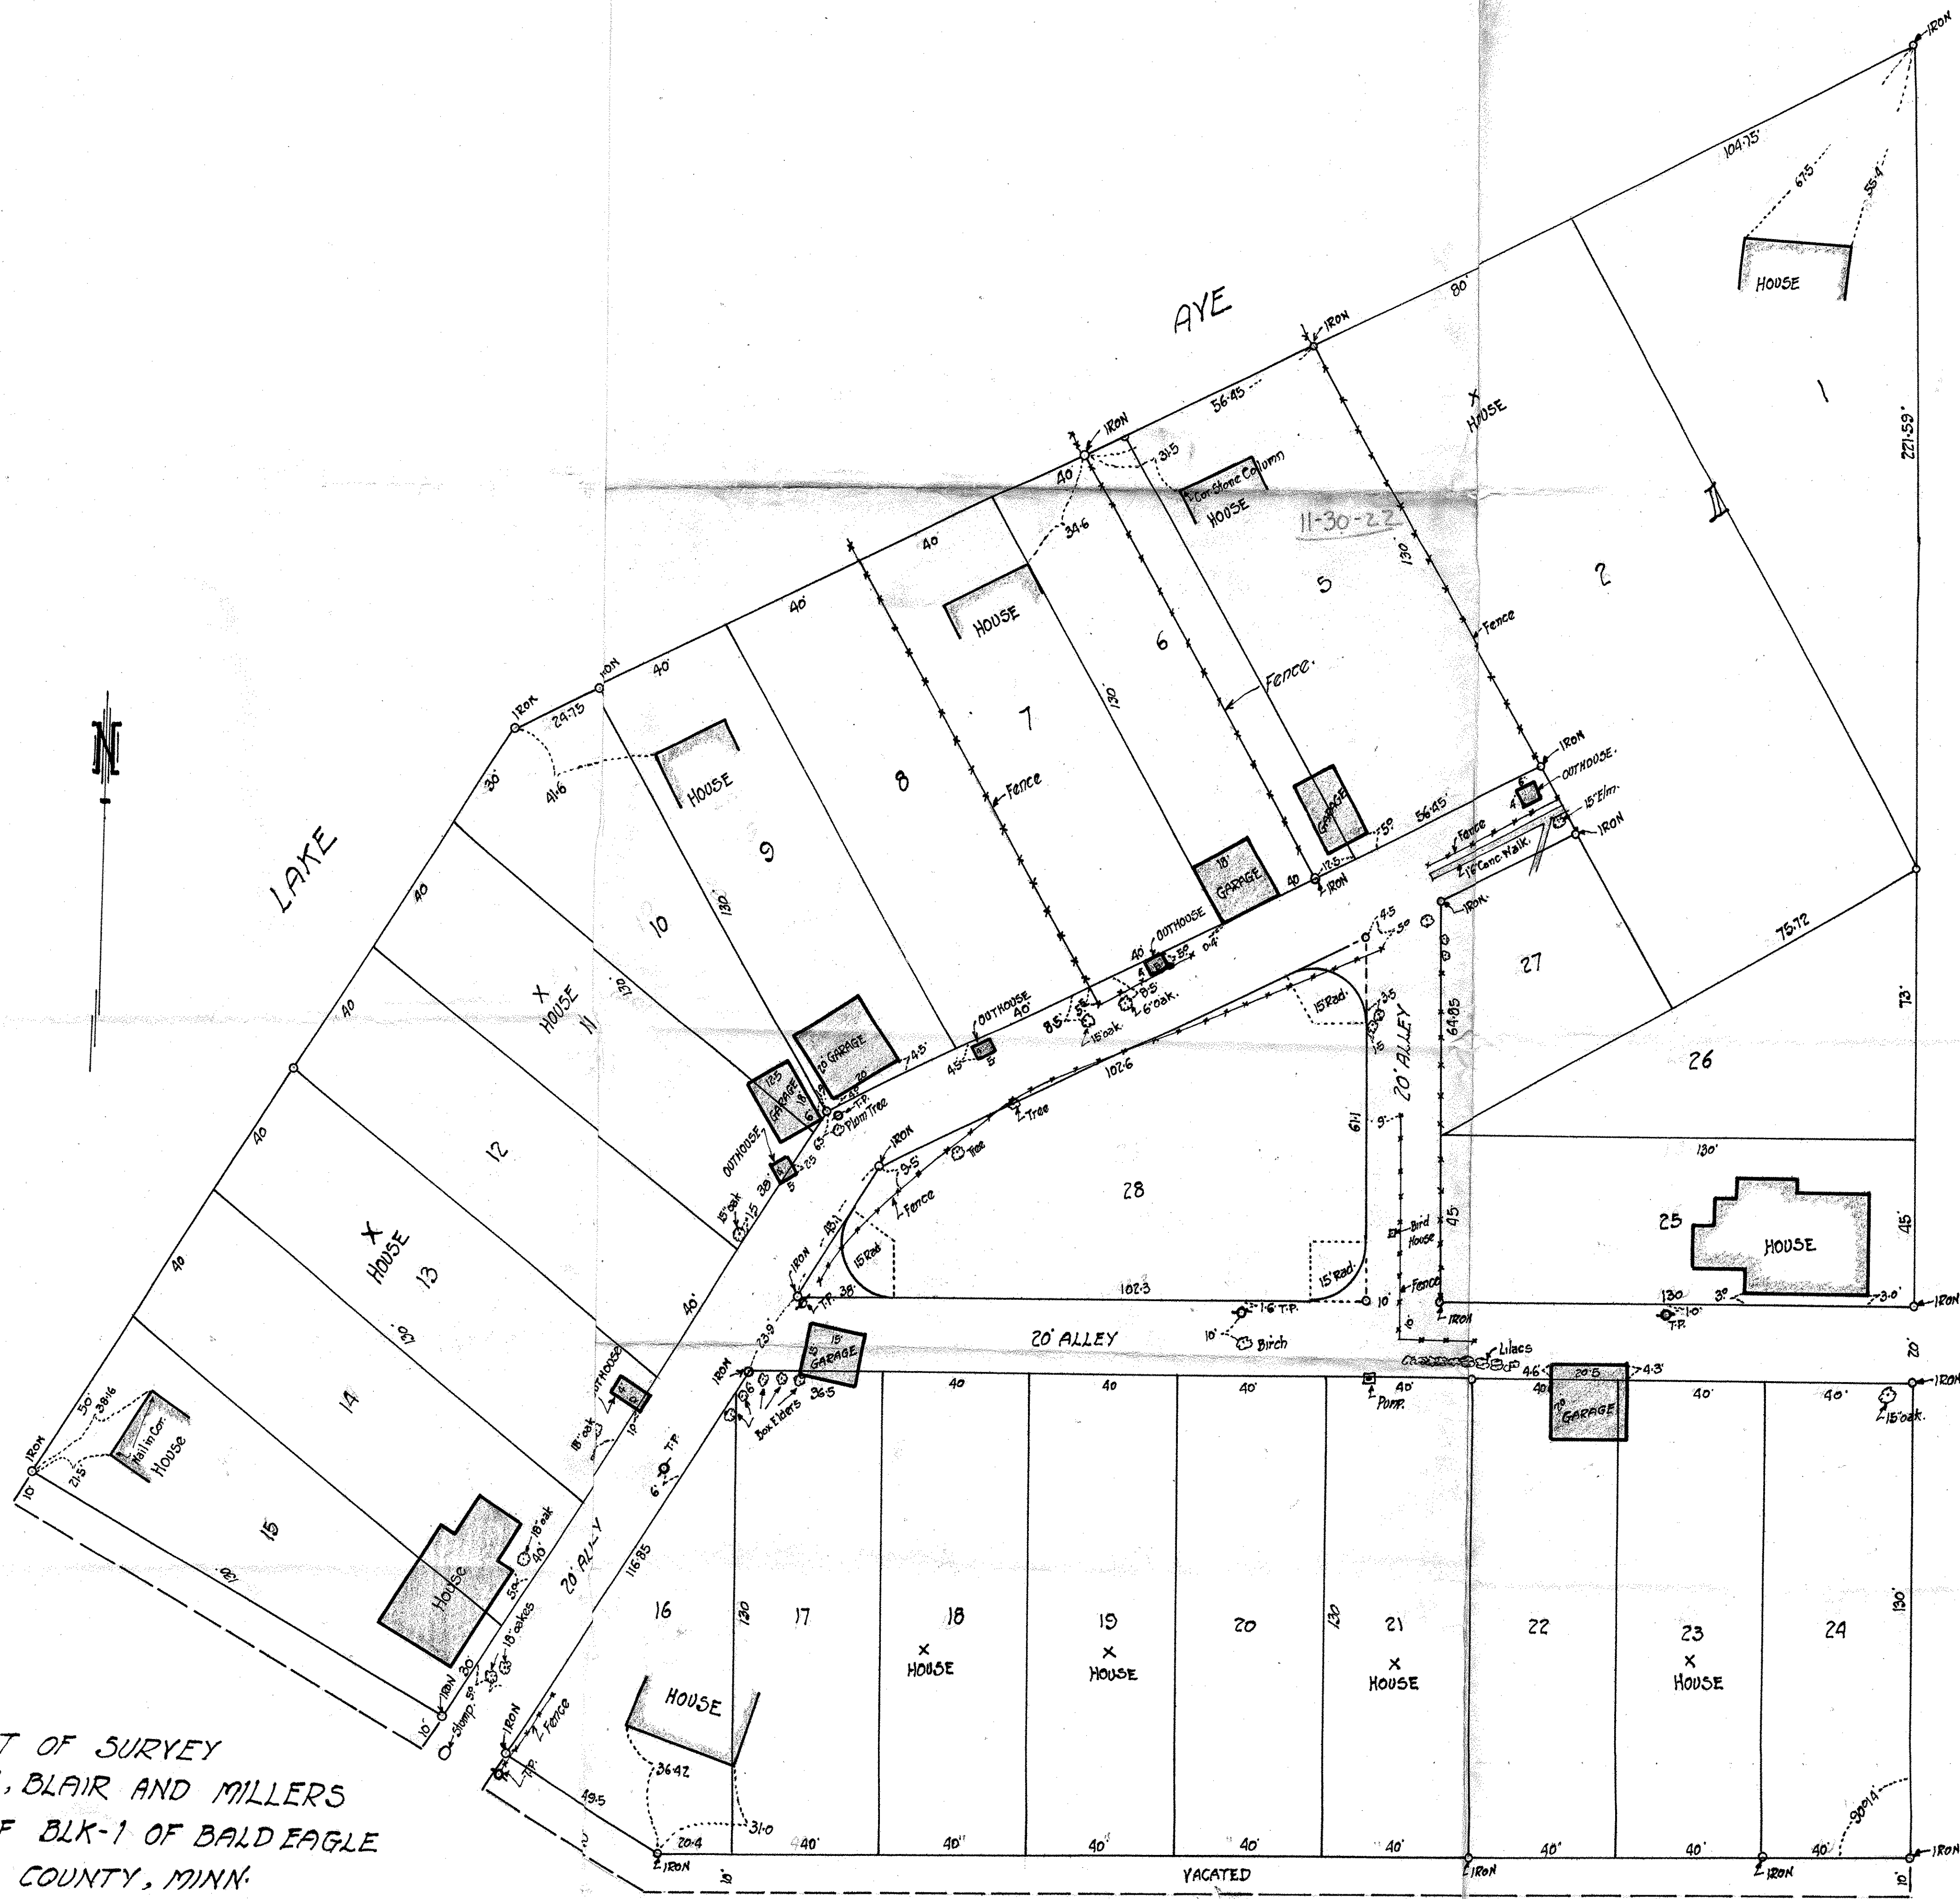 

57