

NORTH 1/3 LOTS 49, 50 & 51


W HITCHCOCK, BRISBINE & MULLEN'S SUBN.

LOTS 1 & 2.

Scale 20ft. per inch LEECH'S OUTF LOTS,

OCT. 3-1916.

JOHN B. IRVINE, SURVEYOR.

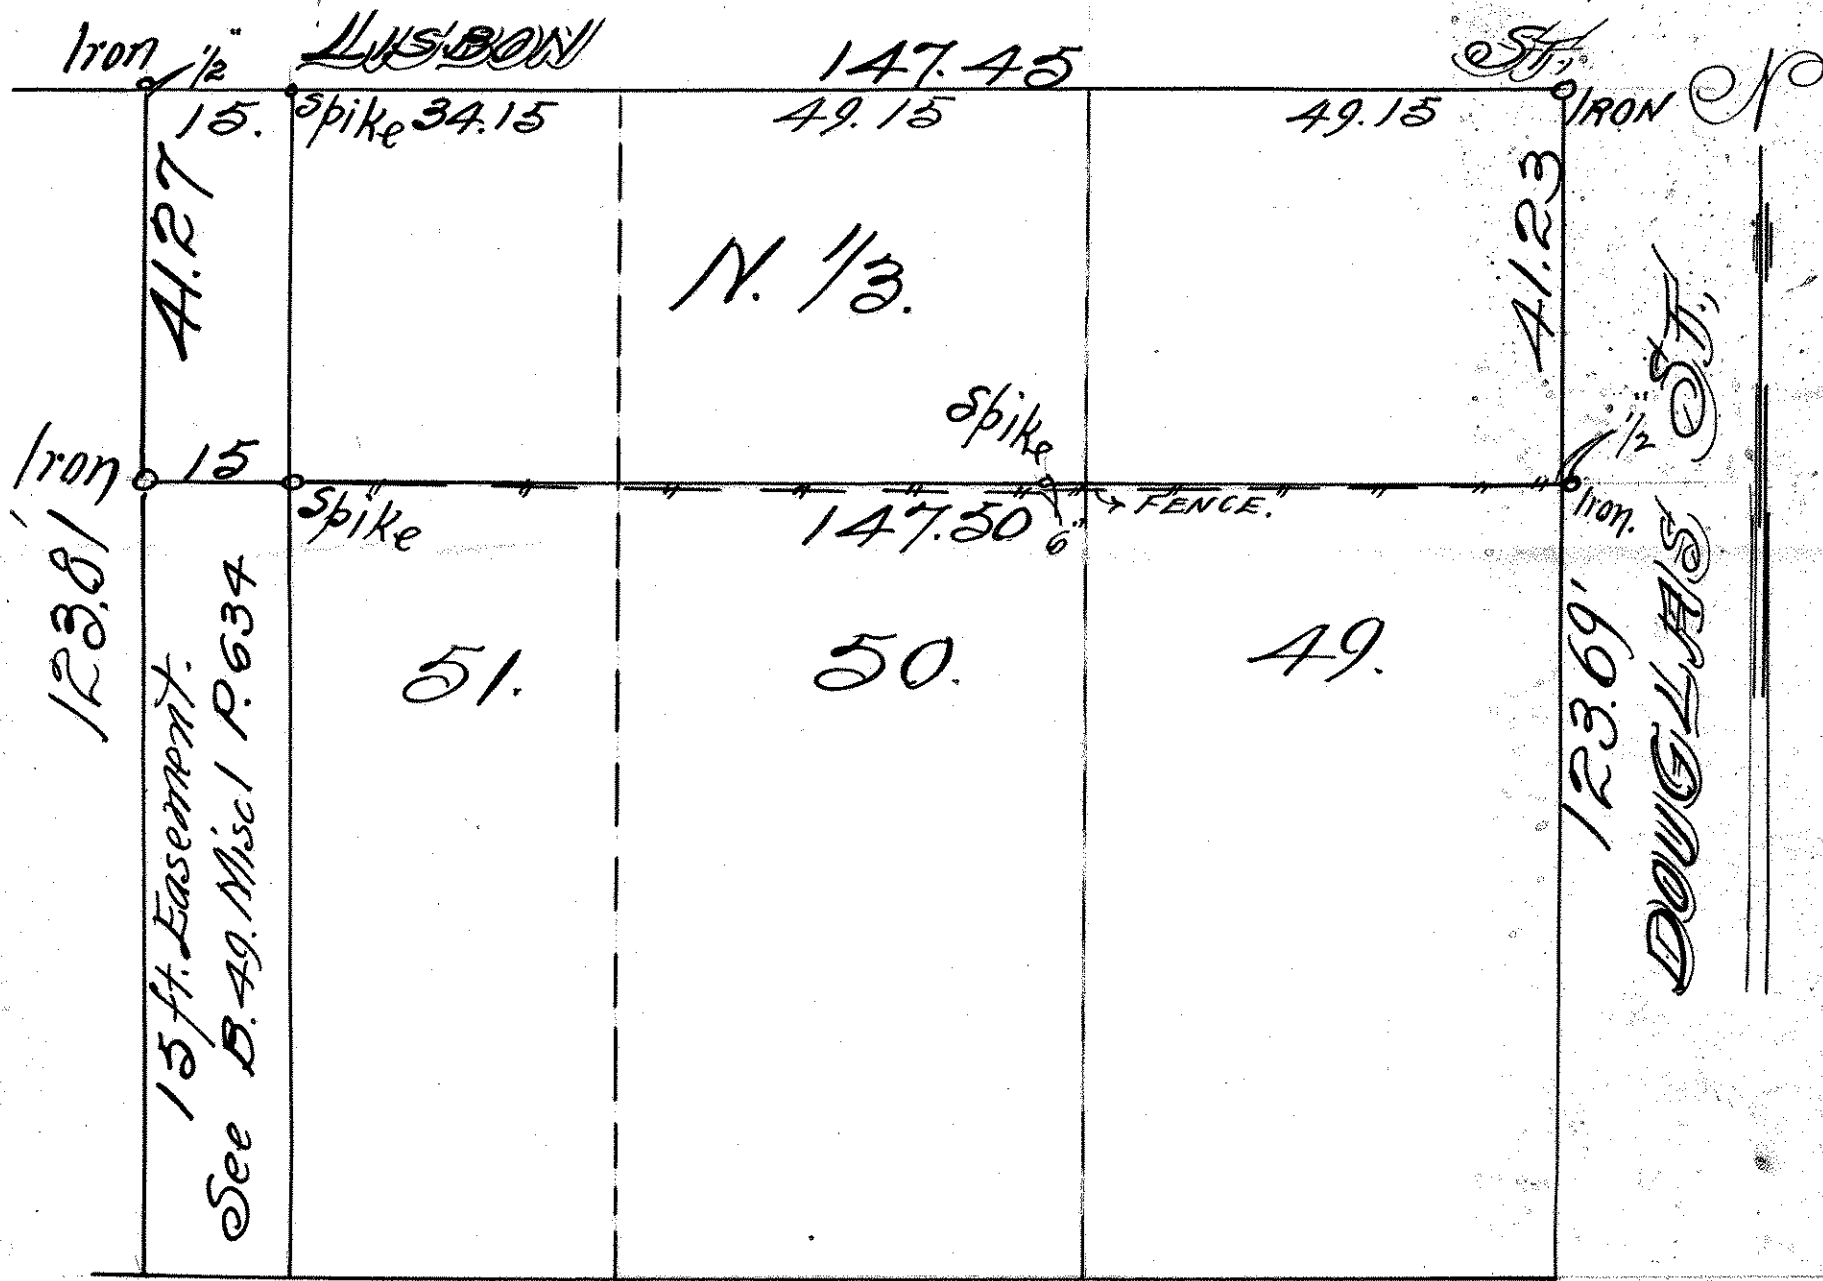

10 07 11 12

ALLEY