PART OF BLOCK 4

WINSLOW'S ADD.

LYING N'WLY. OF CLIFF ST.

John B. Irvine Surveyor.

June 26th 1919.
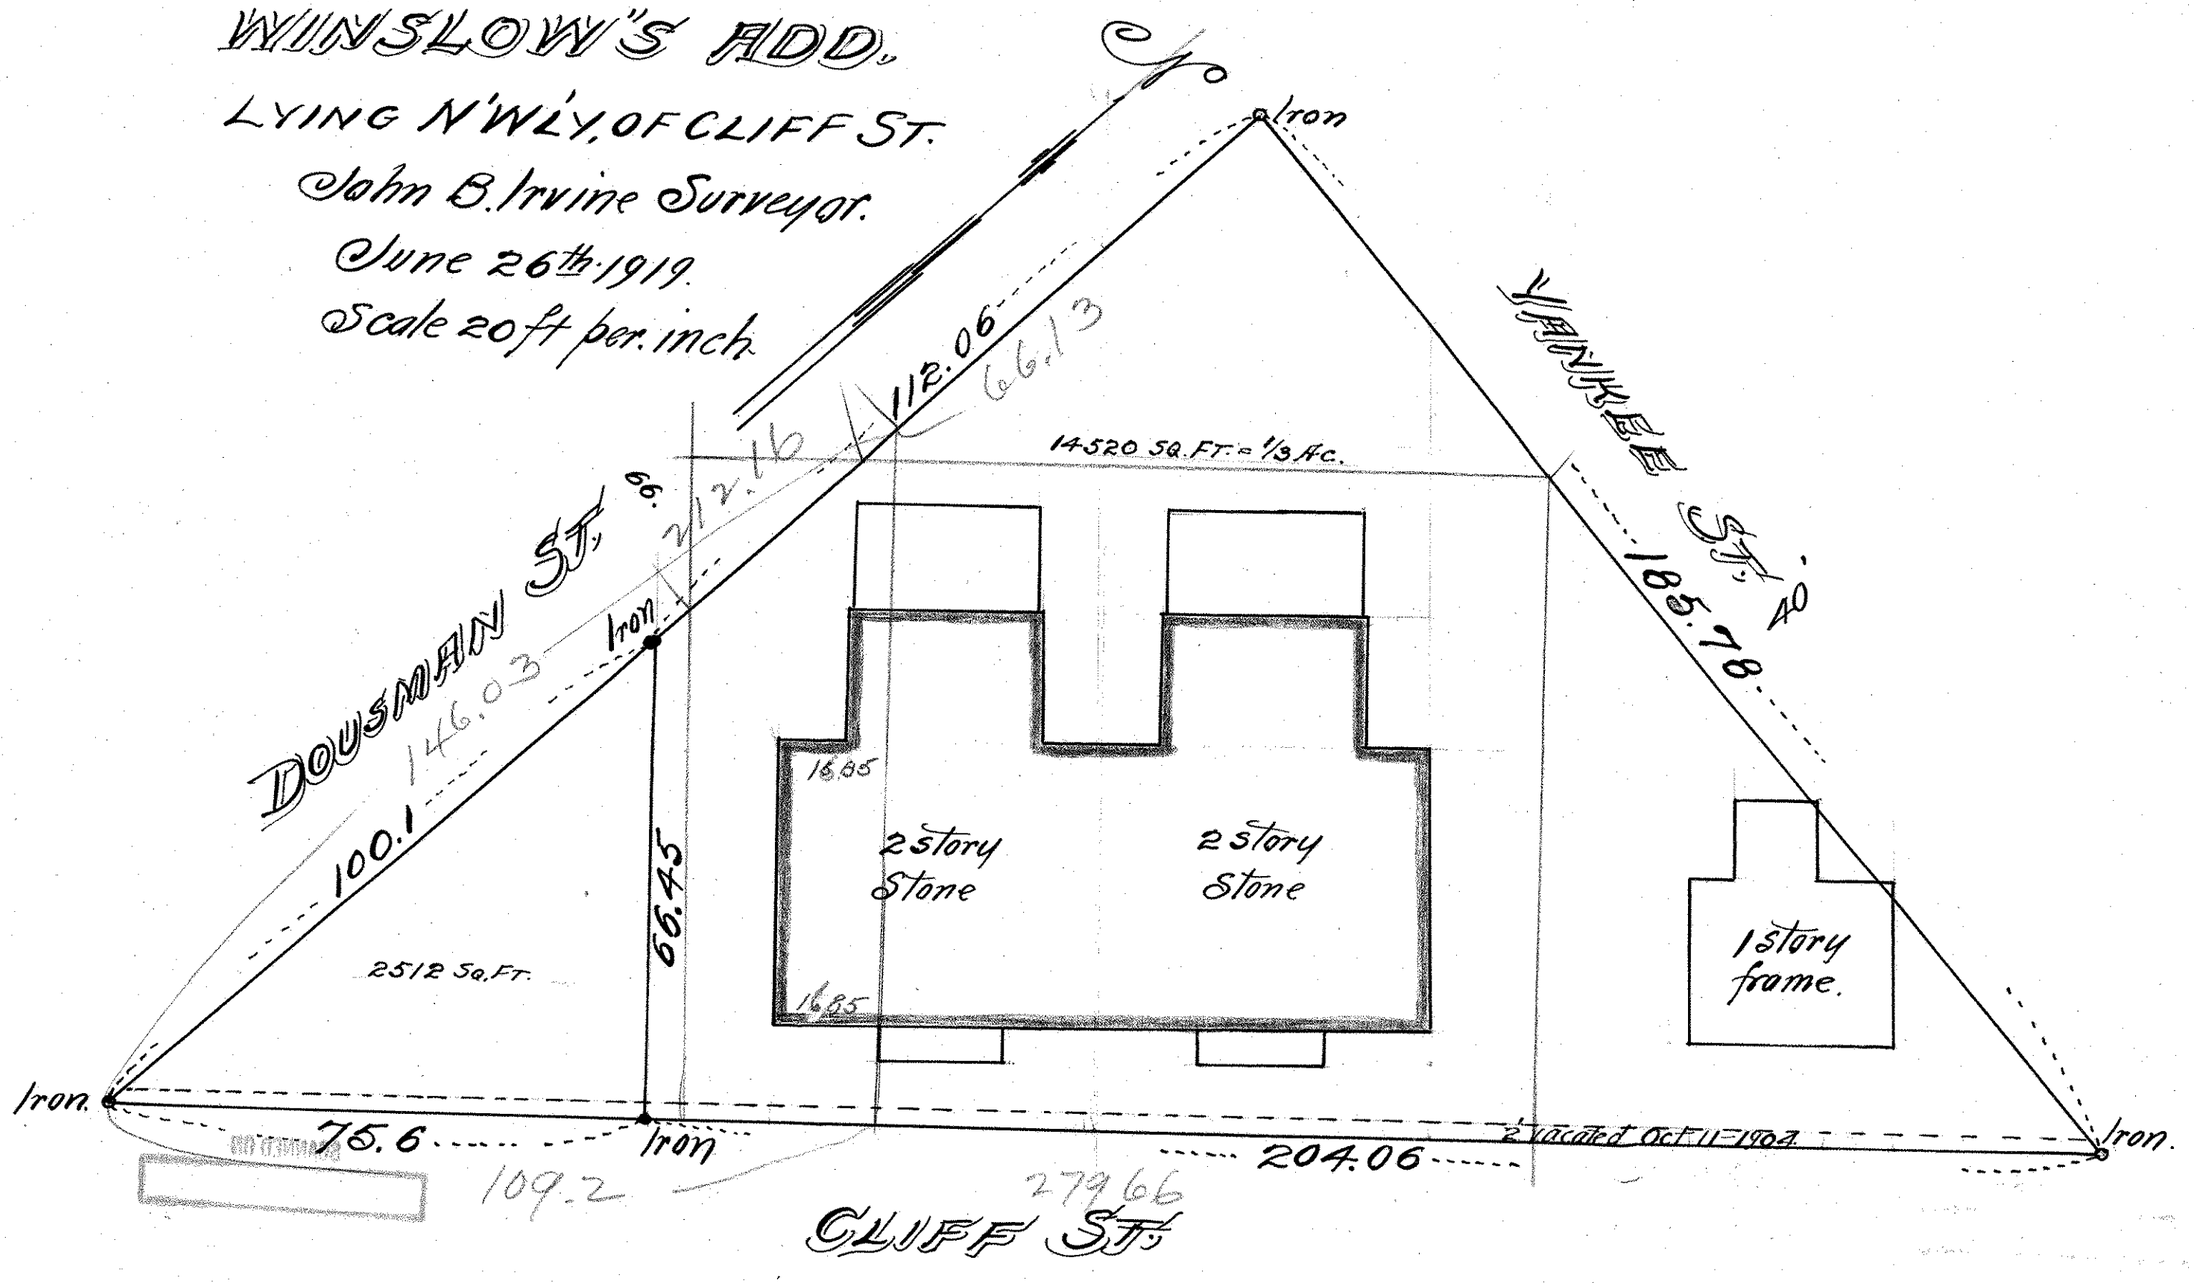
Scale 20 ft per. inch.