

LOT 9 & W. 1/2. LOT 10.  
BLK. 21.  
WINSLOWS ADD.

JOHN B. IRVINE, SURVEYOR.


ST. PAUL MINN.

Scale 20 ft. per inch.

OCT. 14-08.



ST.

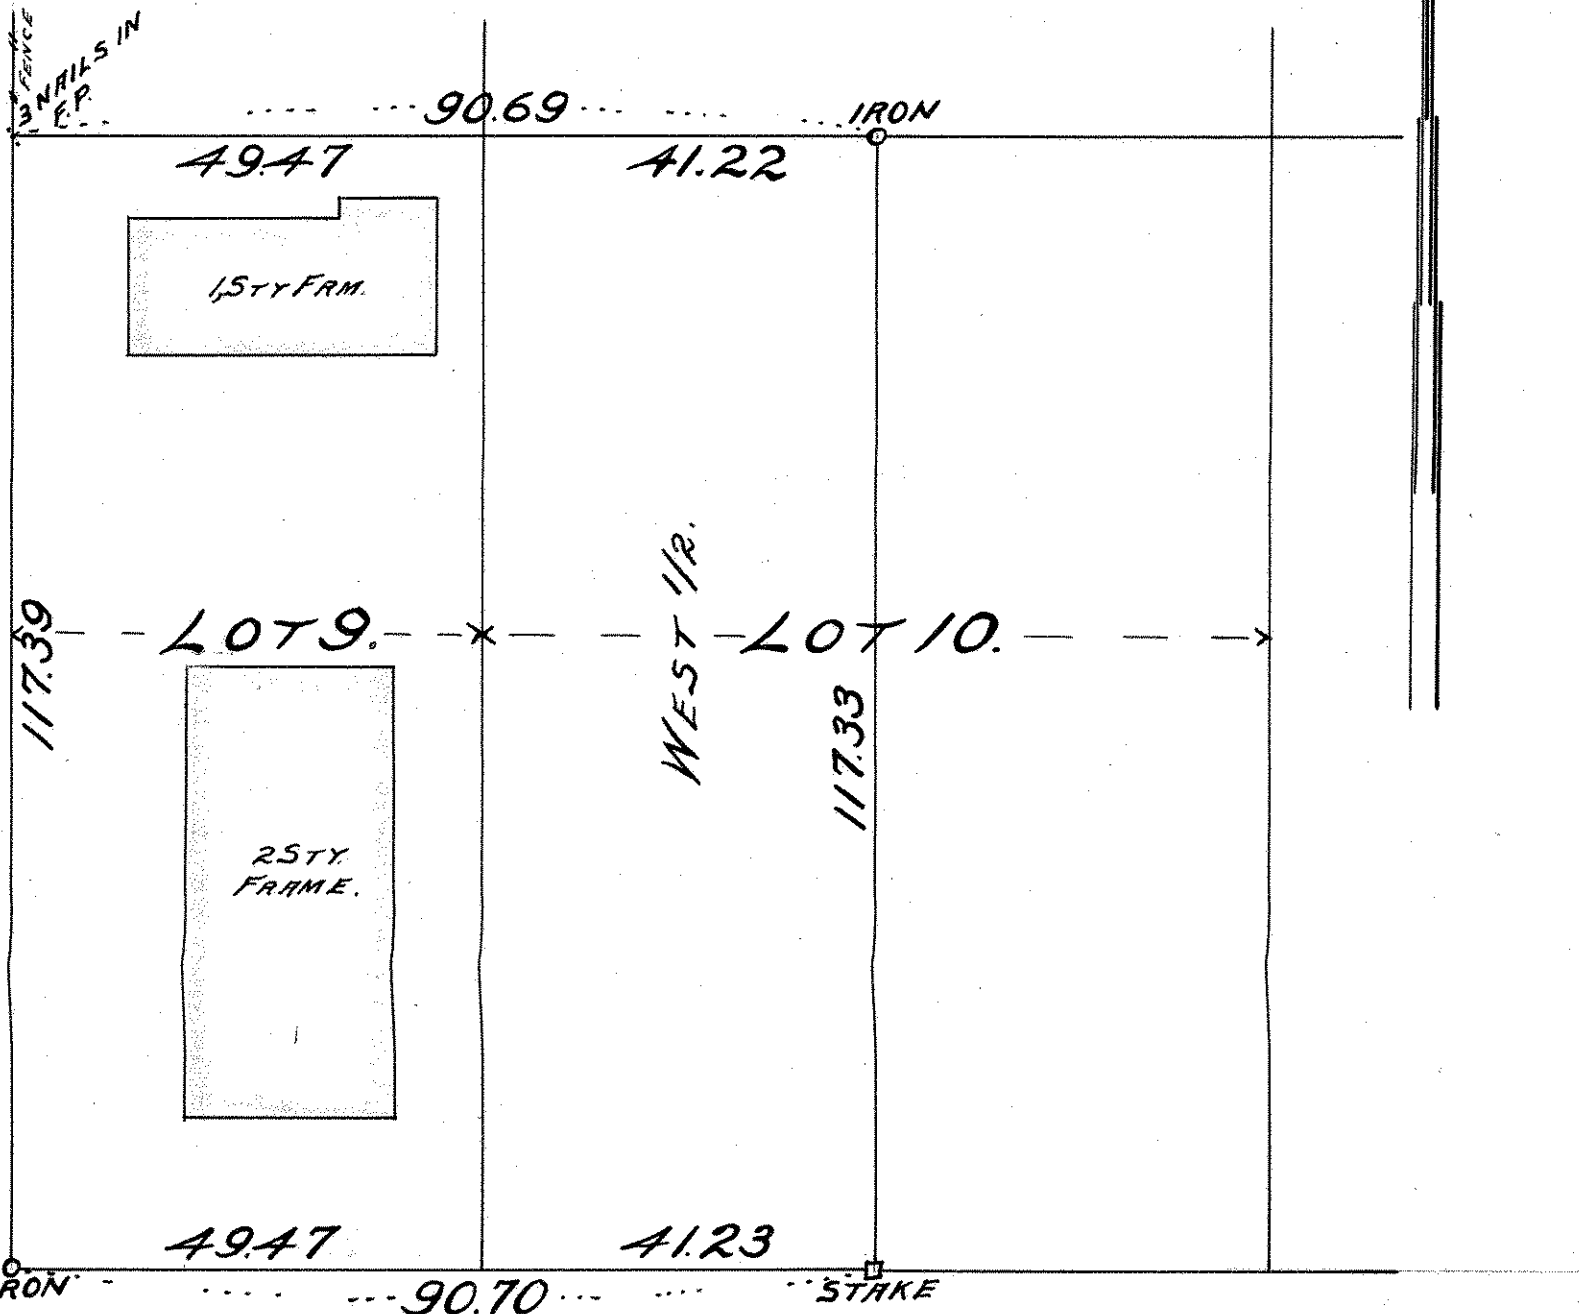

RICHMOND

GOODHUE

ST.