

WINSLOW'S ADD.

SURVEY OF


W. 1/2 LOT 10,

BLK. 8.

JAN, 8, 1917.

JOHN B. IRVINE
SURVEYOR.

SCALE 1"=20'.

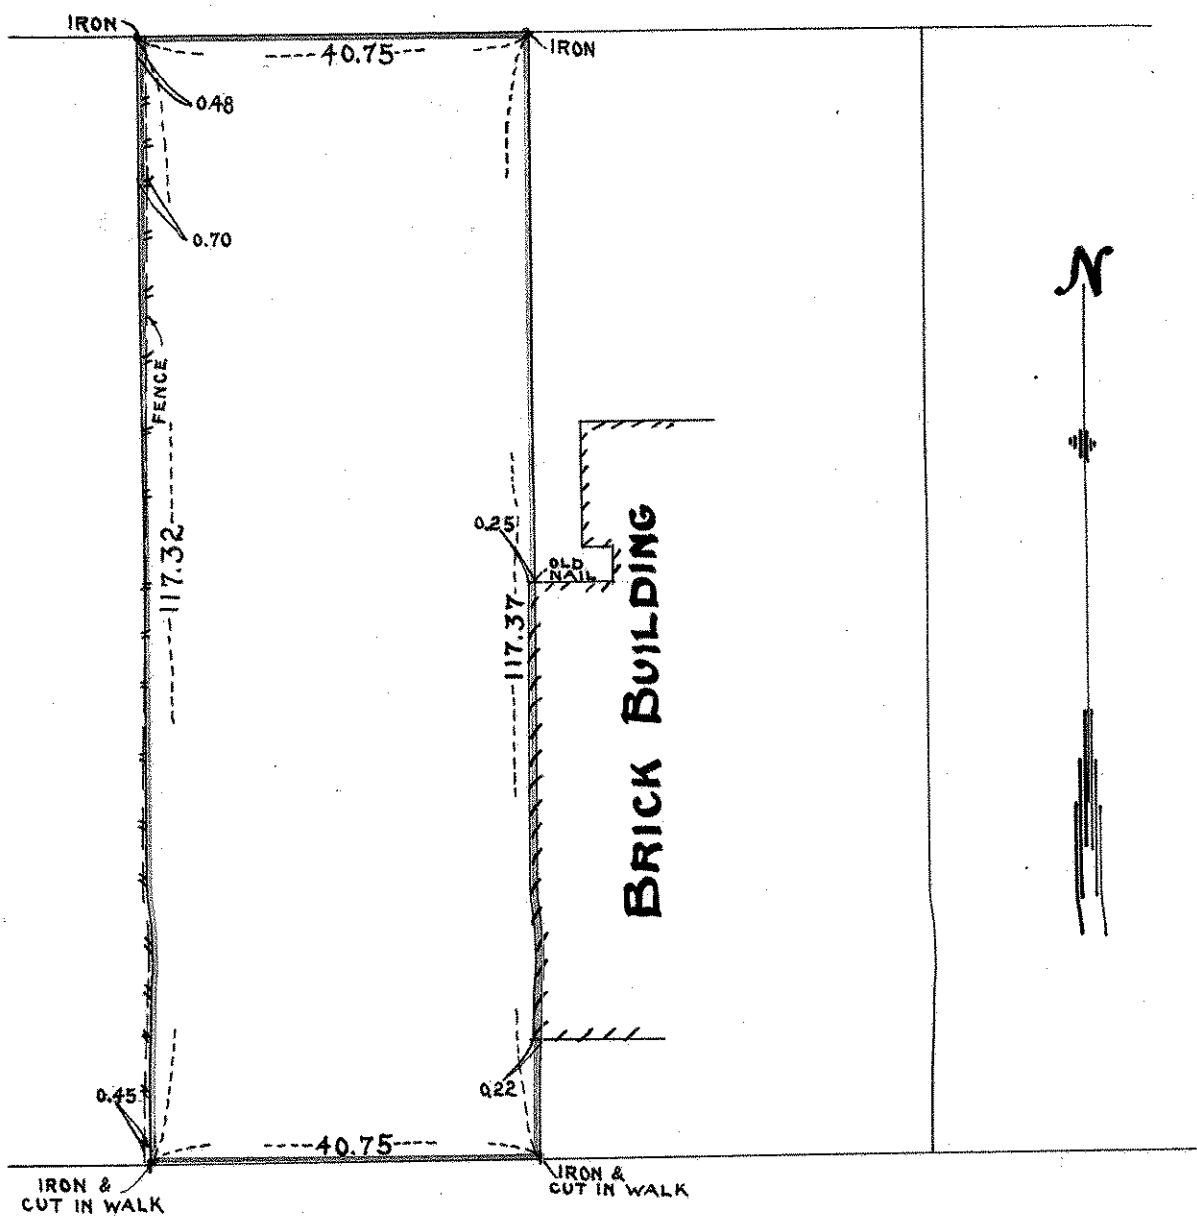

GOODHUE

ST.