


E. 1/2 LOT 8 BLK. 9
WINSTON'S ADD.

20' = 1"

Aug. 31 '03

W. Kartak

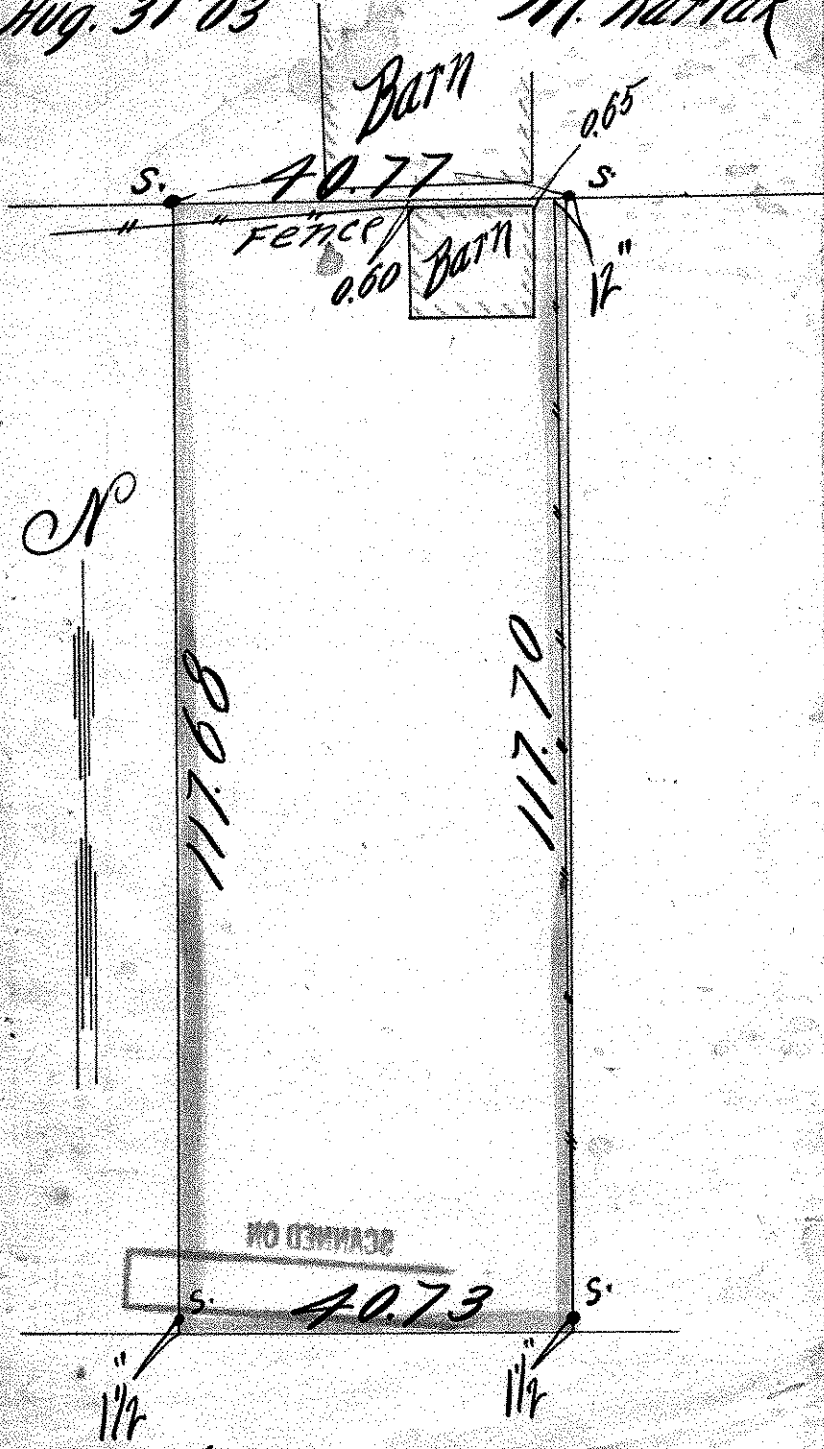

YANKEE ST.