

WEST 1/2 LOT 6 BLK. 21.

WINSLOW'S ADD.

JOHN B. IRVINE SURVEYOR.


ROOM 508 GLOBE BLDG

ST PAUL MINN.

SCALE 1 IN = 10 FT.

JULY 7-05

BANFIL ST.

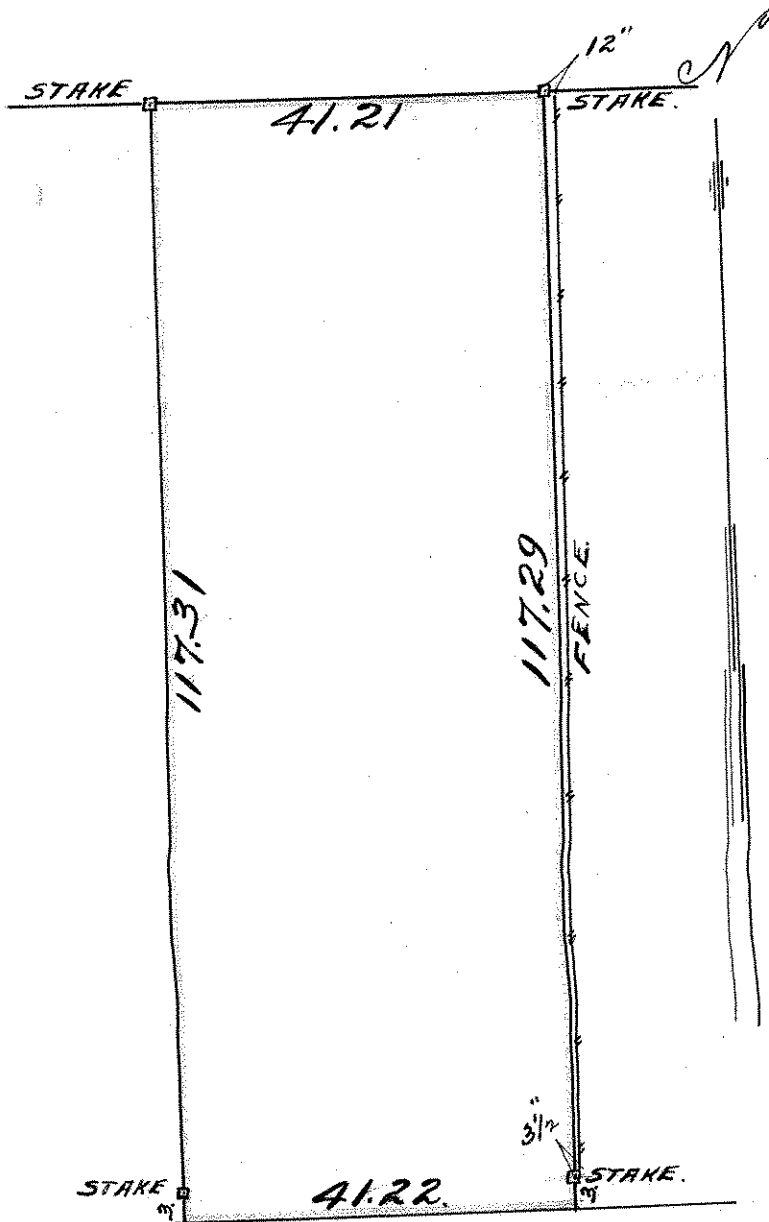

NO CHANGE

