LOT 5 EISWERTH'S SUB of
LOTS 2 & 3 BLOCK 10
WINSLOW'S ADD.

JOHN B. IRVINE SURVEYOR.
416 GLOBE BLDG.
ST PAUL MINN.
MCH. 23-07
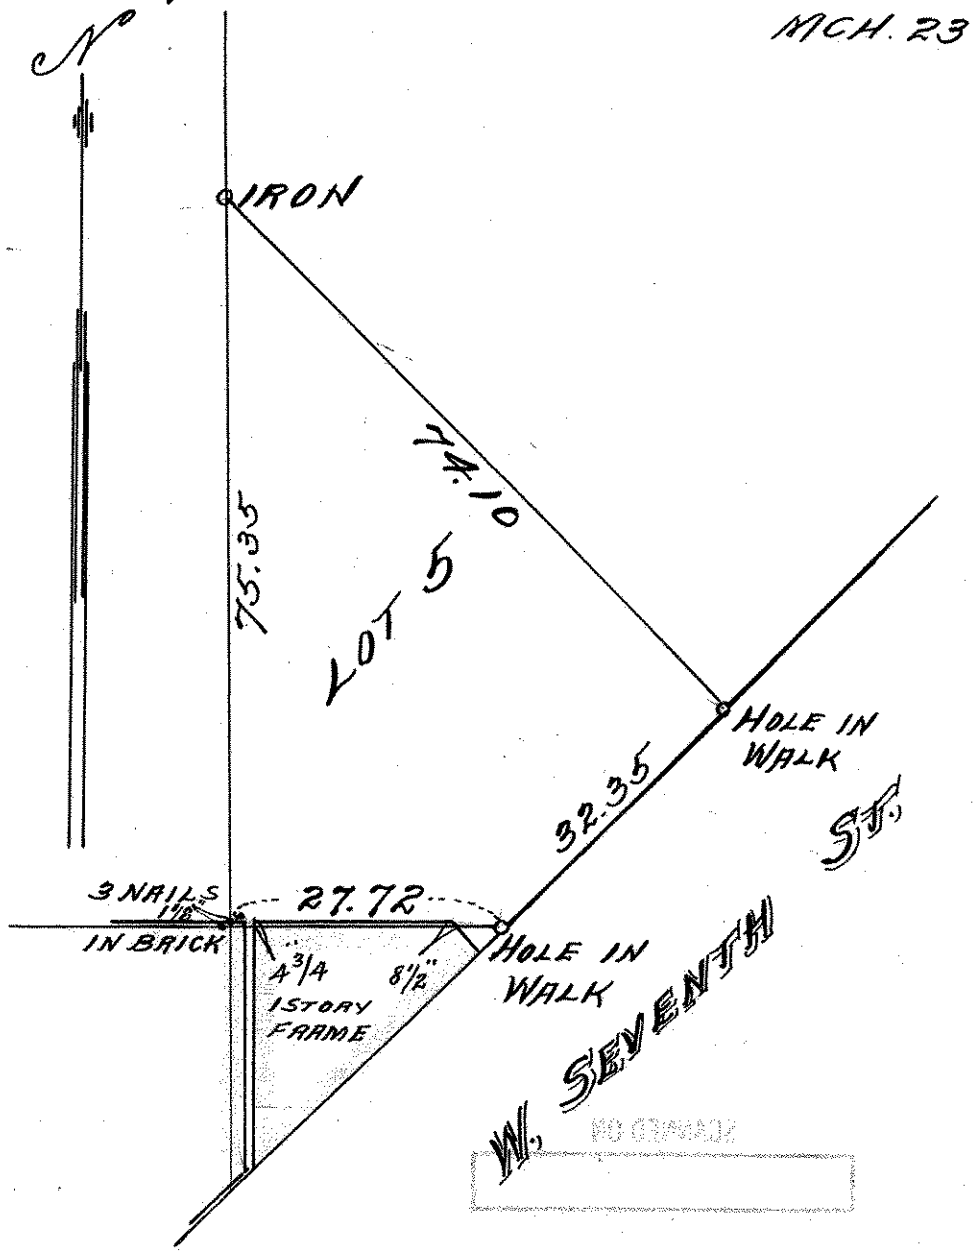
SCALE 20 ft. per inch.