

FISCHER & LIENAU'S SUB.

OF PART OF LOTS 186.

ZEIGLER & MAINZER'S SUB

BLK. 13.

WINSLOW'S ADD.

JOHN B. IRVINE SURVEYOR.

ROOM 508 GLOBE BLDG.

ST PAUL MINN.


APRIL 11-05.

SCALE 30' = 1"

DOUSMAN

VON MINDEN ST.

ANN ST.

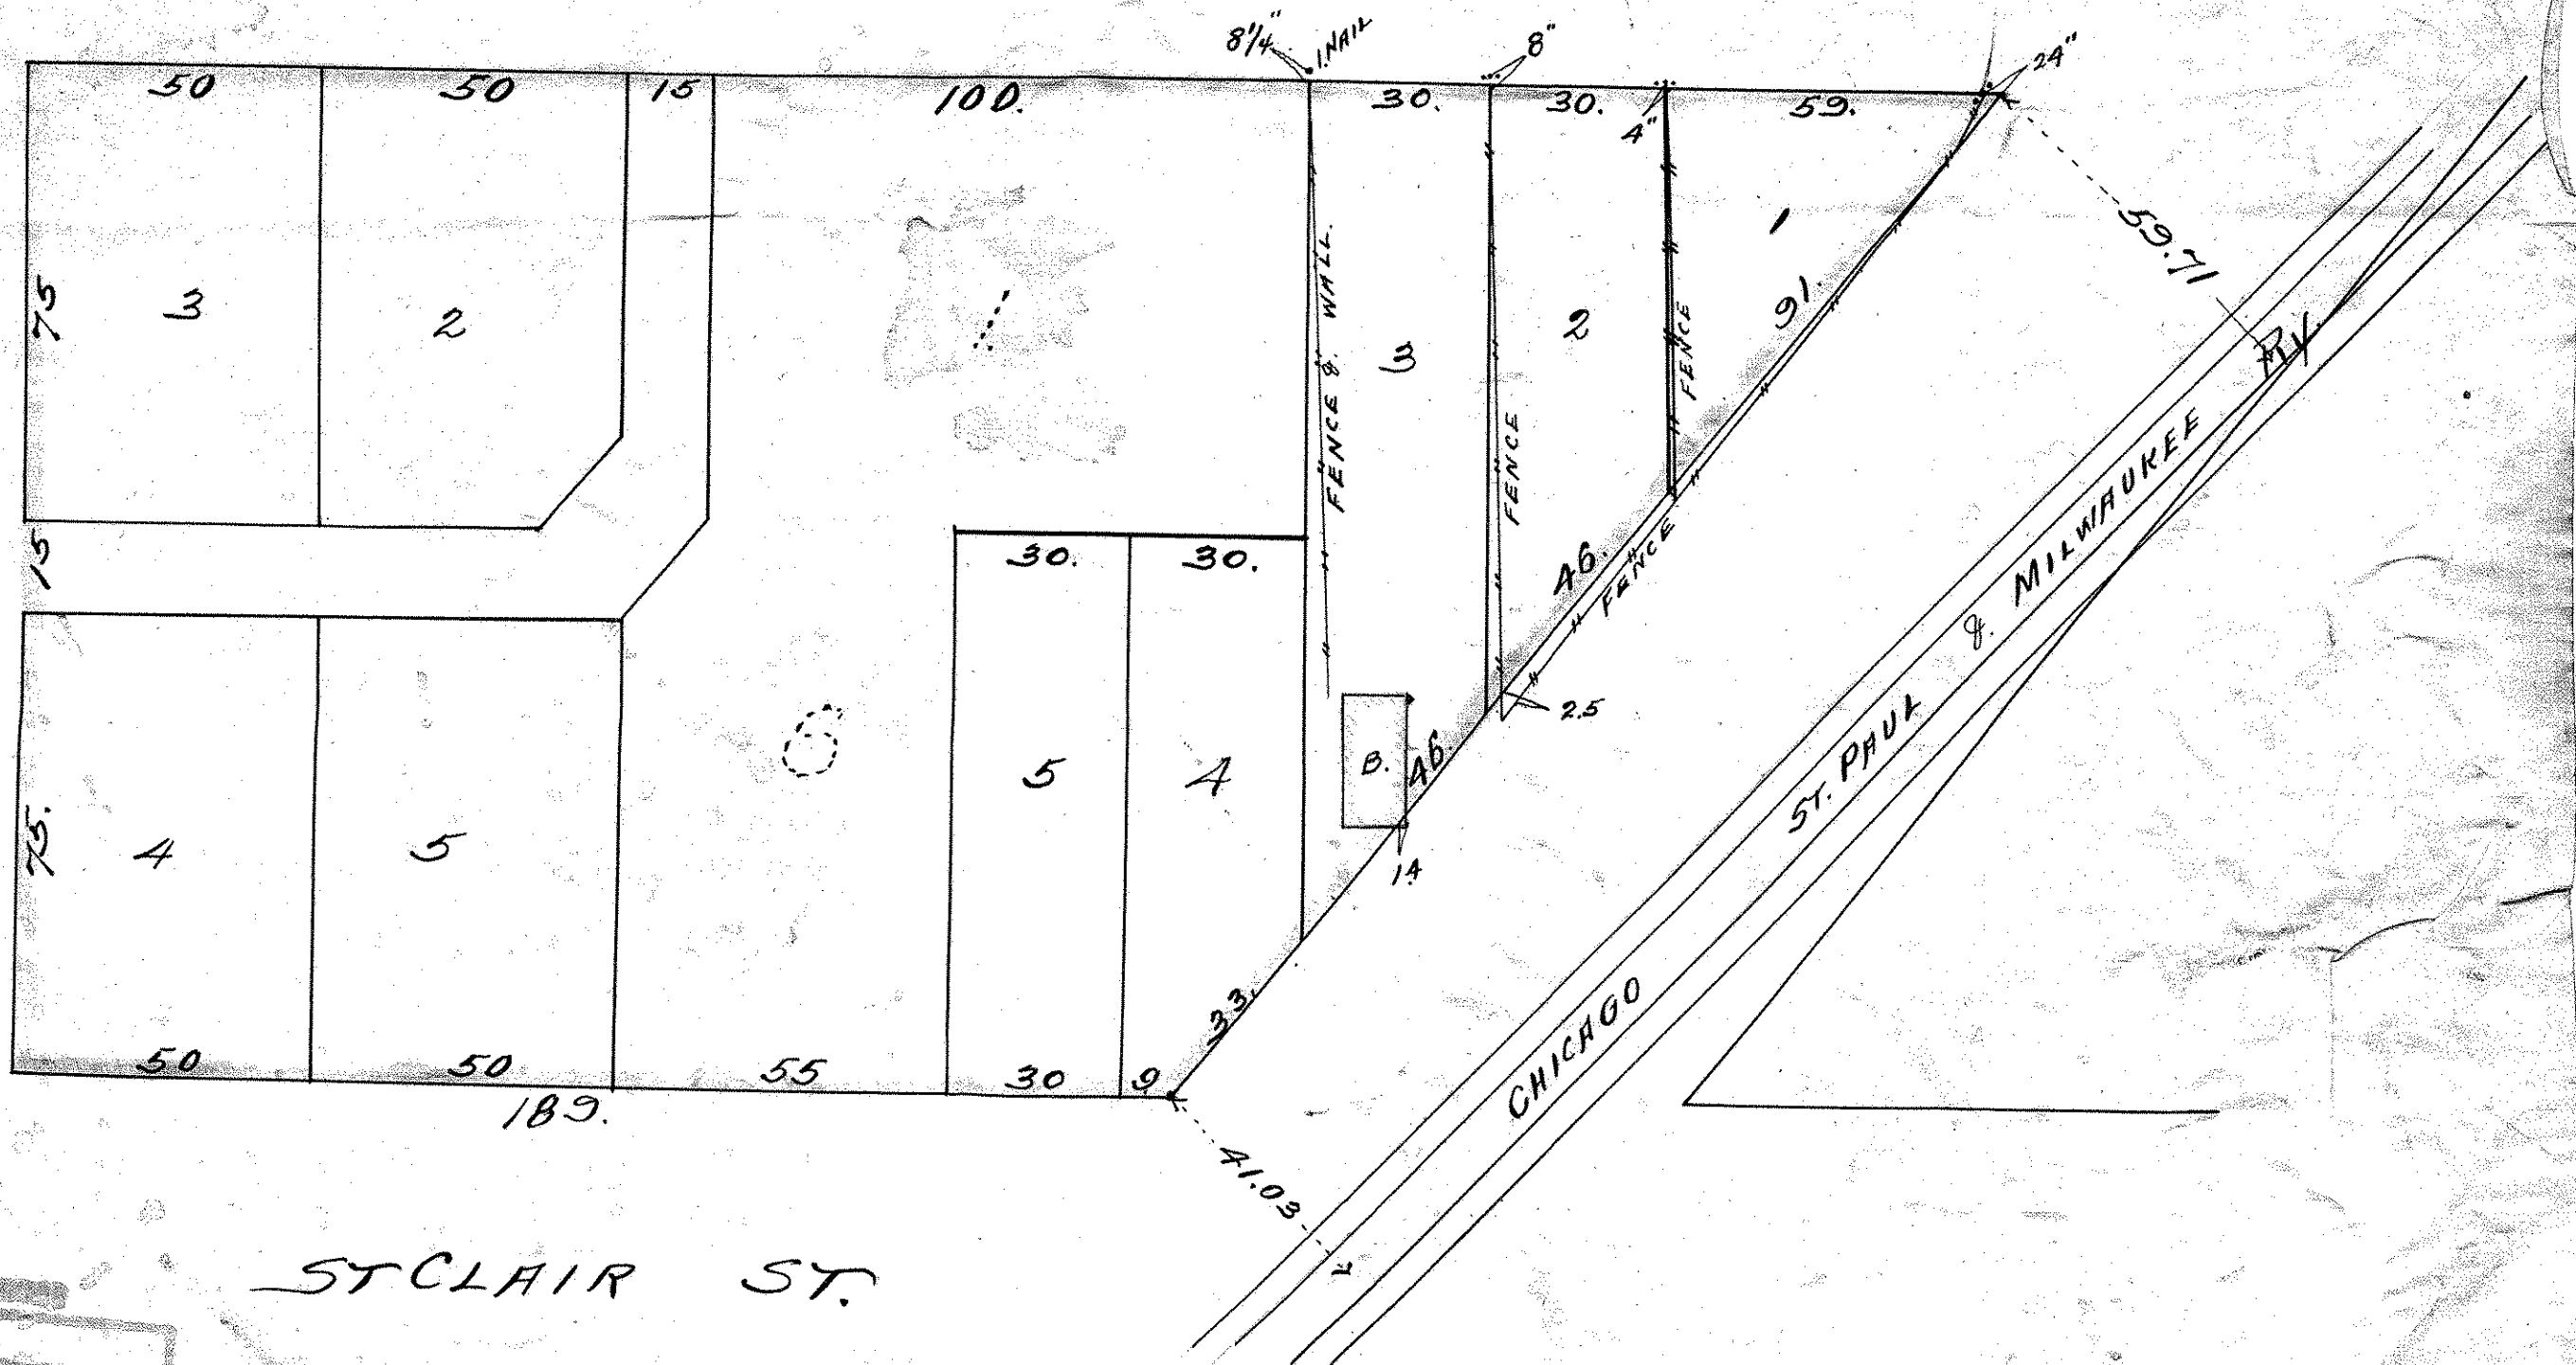

ST CLAIR ST.