

# Certificate of Survey

From the office of  
**GEORGI-SCHMIDT & ASSOC. INC.**  
 3092 No. Lexington Ave., Roseville, Mn. 55113  
 LAND SURVEYING  
 483-4408

I Hereby Certify that this plat shows a survey made by me of the property described on this plat, and that the corners are correctly placed as shown,

Job Number: 1182

Surveyed For Lavence Scherer

Date 6/24/82

Scale 1" = 40'


By Donald W. Schmidt  
 REGISTERED LAND SURVEYOR

**Description:**

Lot 3, Block 55, White Bear

Ramsay County, MN

FOURTH ST.

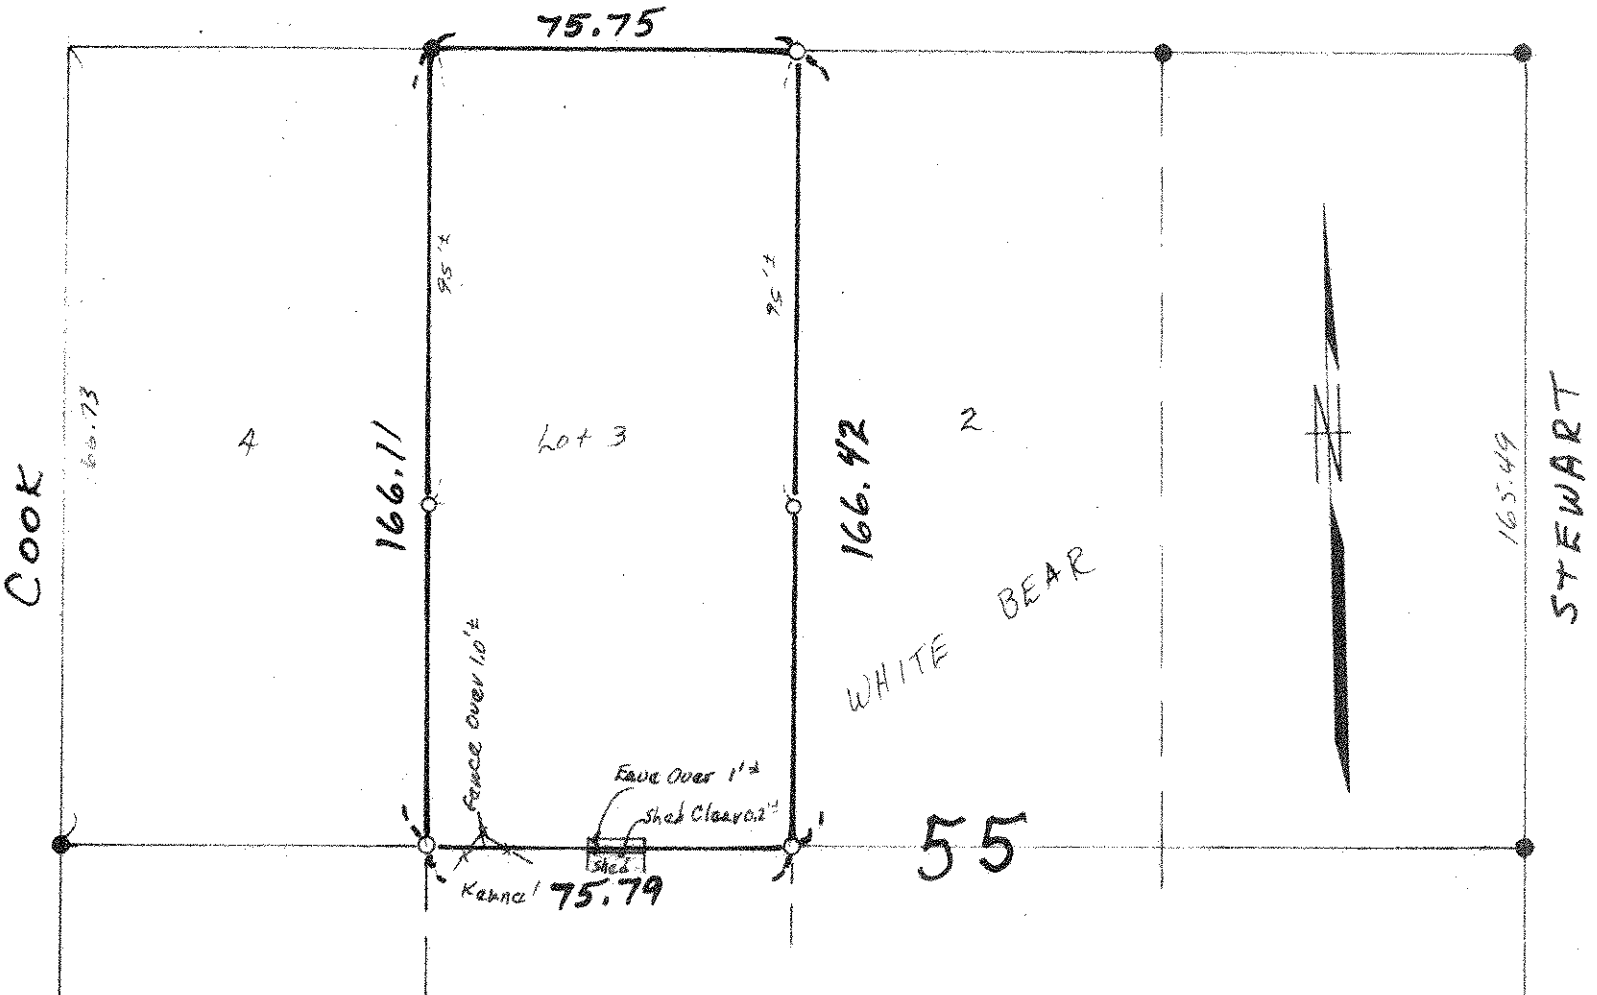

○ Denotes Iron Pipe Monument Set  
 ● Denotes Iron Found in place

SCANNED ON