Sec 14 T30 R22

FROM THE OFFICE OF

CHARLES O. GEORGI COMPANY

2215 West County Road B Saint Paul, Minnesota 55113

REGISTERED CIVIL ENGINEER AND LAND SURVEYOR

Certificate of Survey

I Hereby Certify that this plat shows a survey made by me of the property described on this plat, and that the corners are correctly placed as shown, and that all locations have been correctly shown.

Surveyed For Progressive Design Assoc.

Date April 1966

Scale 1" = 40'

By Charles O. Georgi
REGISTERED LAND SURVEYOR

Description:

Lots 3 and 4
Block 51
White Bear
Ramsey County Minn

Calculated Area = 24,900 Sq.Ft more or less

BM #198 = 938.77 Iron Cap on pipe W. edge of walk E. side of Park NE of Post office Bldg

BM Top Hyd = 940.27 NE Cor. of Banning & 5th St.

T.C. denotes Top of Curb
E.W. denotes on edge of walk.

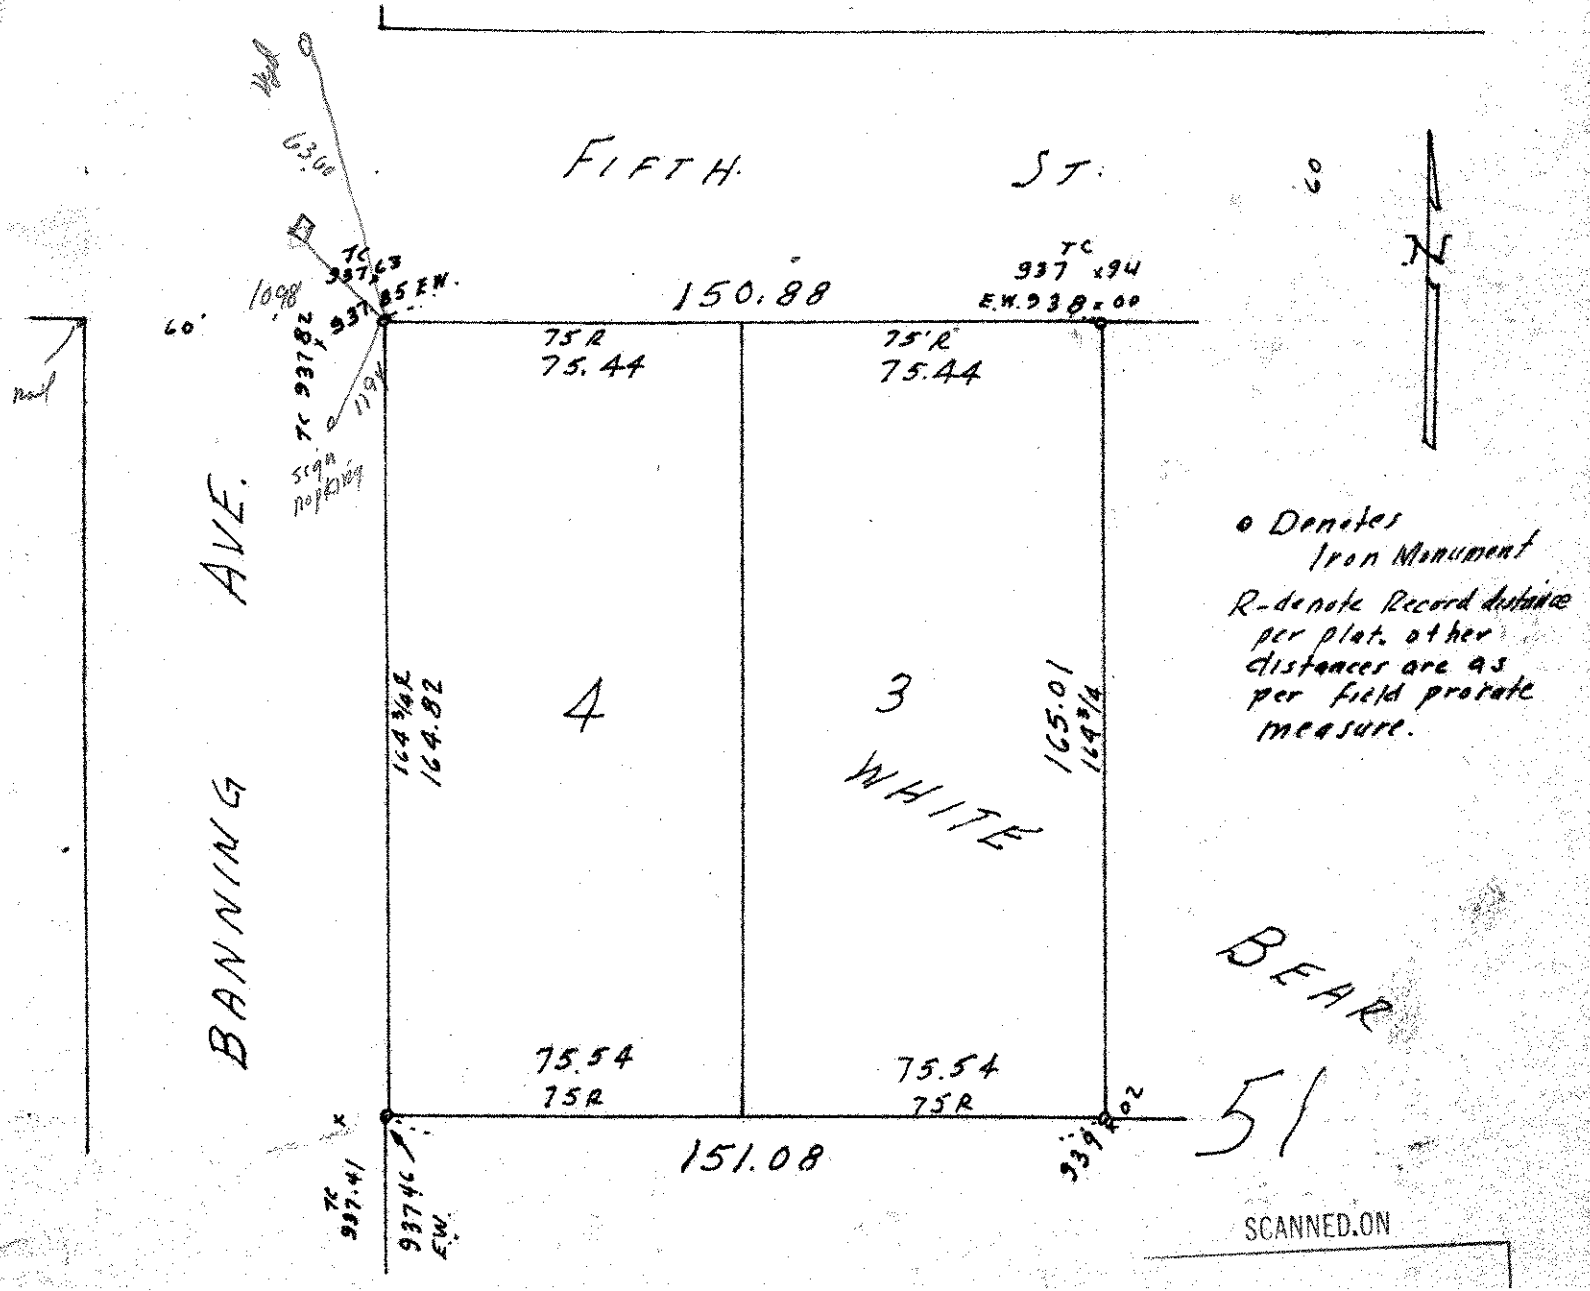

SCANNED ON