

CHARLES O. GEORGI COMPANY

2215 West County Road B

Saint Paul, Minnesota 55113

REGISTERED CIVIL ENGINEER AND LAND SURVEYOR

Certificate of Survey

I Hereby Certify that this plat shows a survey made by me of the property described on this plat, and that the corners are correctly placed as shown, and that all locations have been correctly shown.

Surveyed For.....*H.A. Chapman*

Date.....*September 1967*


Scale.....*1" = 50'*

By.....*Charles O. Georgi*
REGISTERED LAND SURVEYOR

Description:

All of Lot 5 and the South
65 feet of Lot 4,
Block 37
WHITE BEAR
Ramsey County, Minn.

o - Denotes Iron
pipe monument

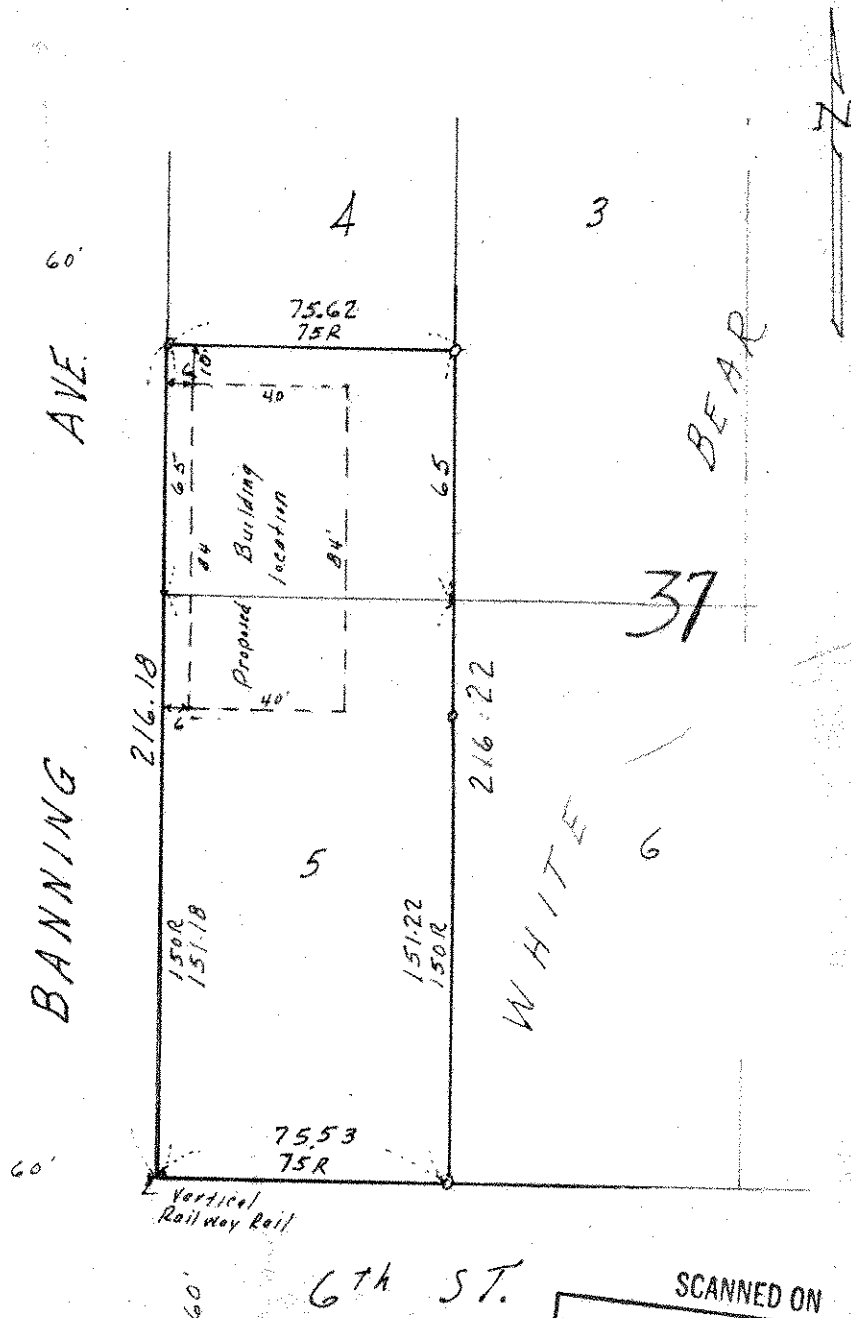

SCANNED ON