

CENTER LINE FAIRVIEW PLACE


BETWEEN BLOCKS 10 & 3 GARDEN PLACE IN REFERENCE TO LINES OF
LOTS 12, 13, 14, 15, 16 & 17 WHITE BEAR BEACH.

JOHN B. IRVINE SURVEYOR.
Scale 20 Feet per inch

JAN 29th 1904.

FIRST

ST.

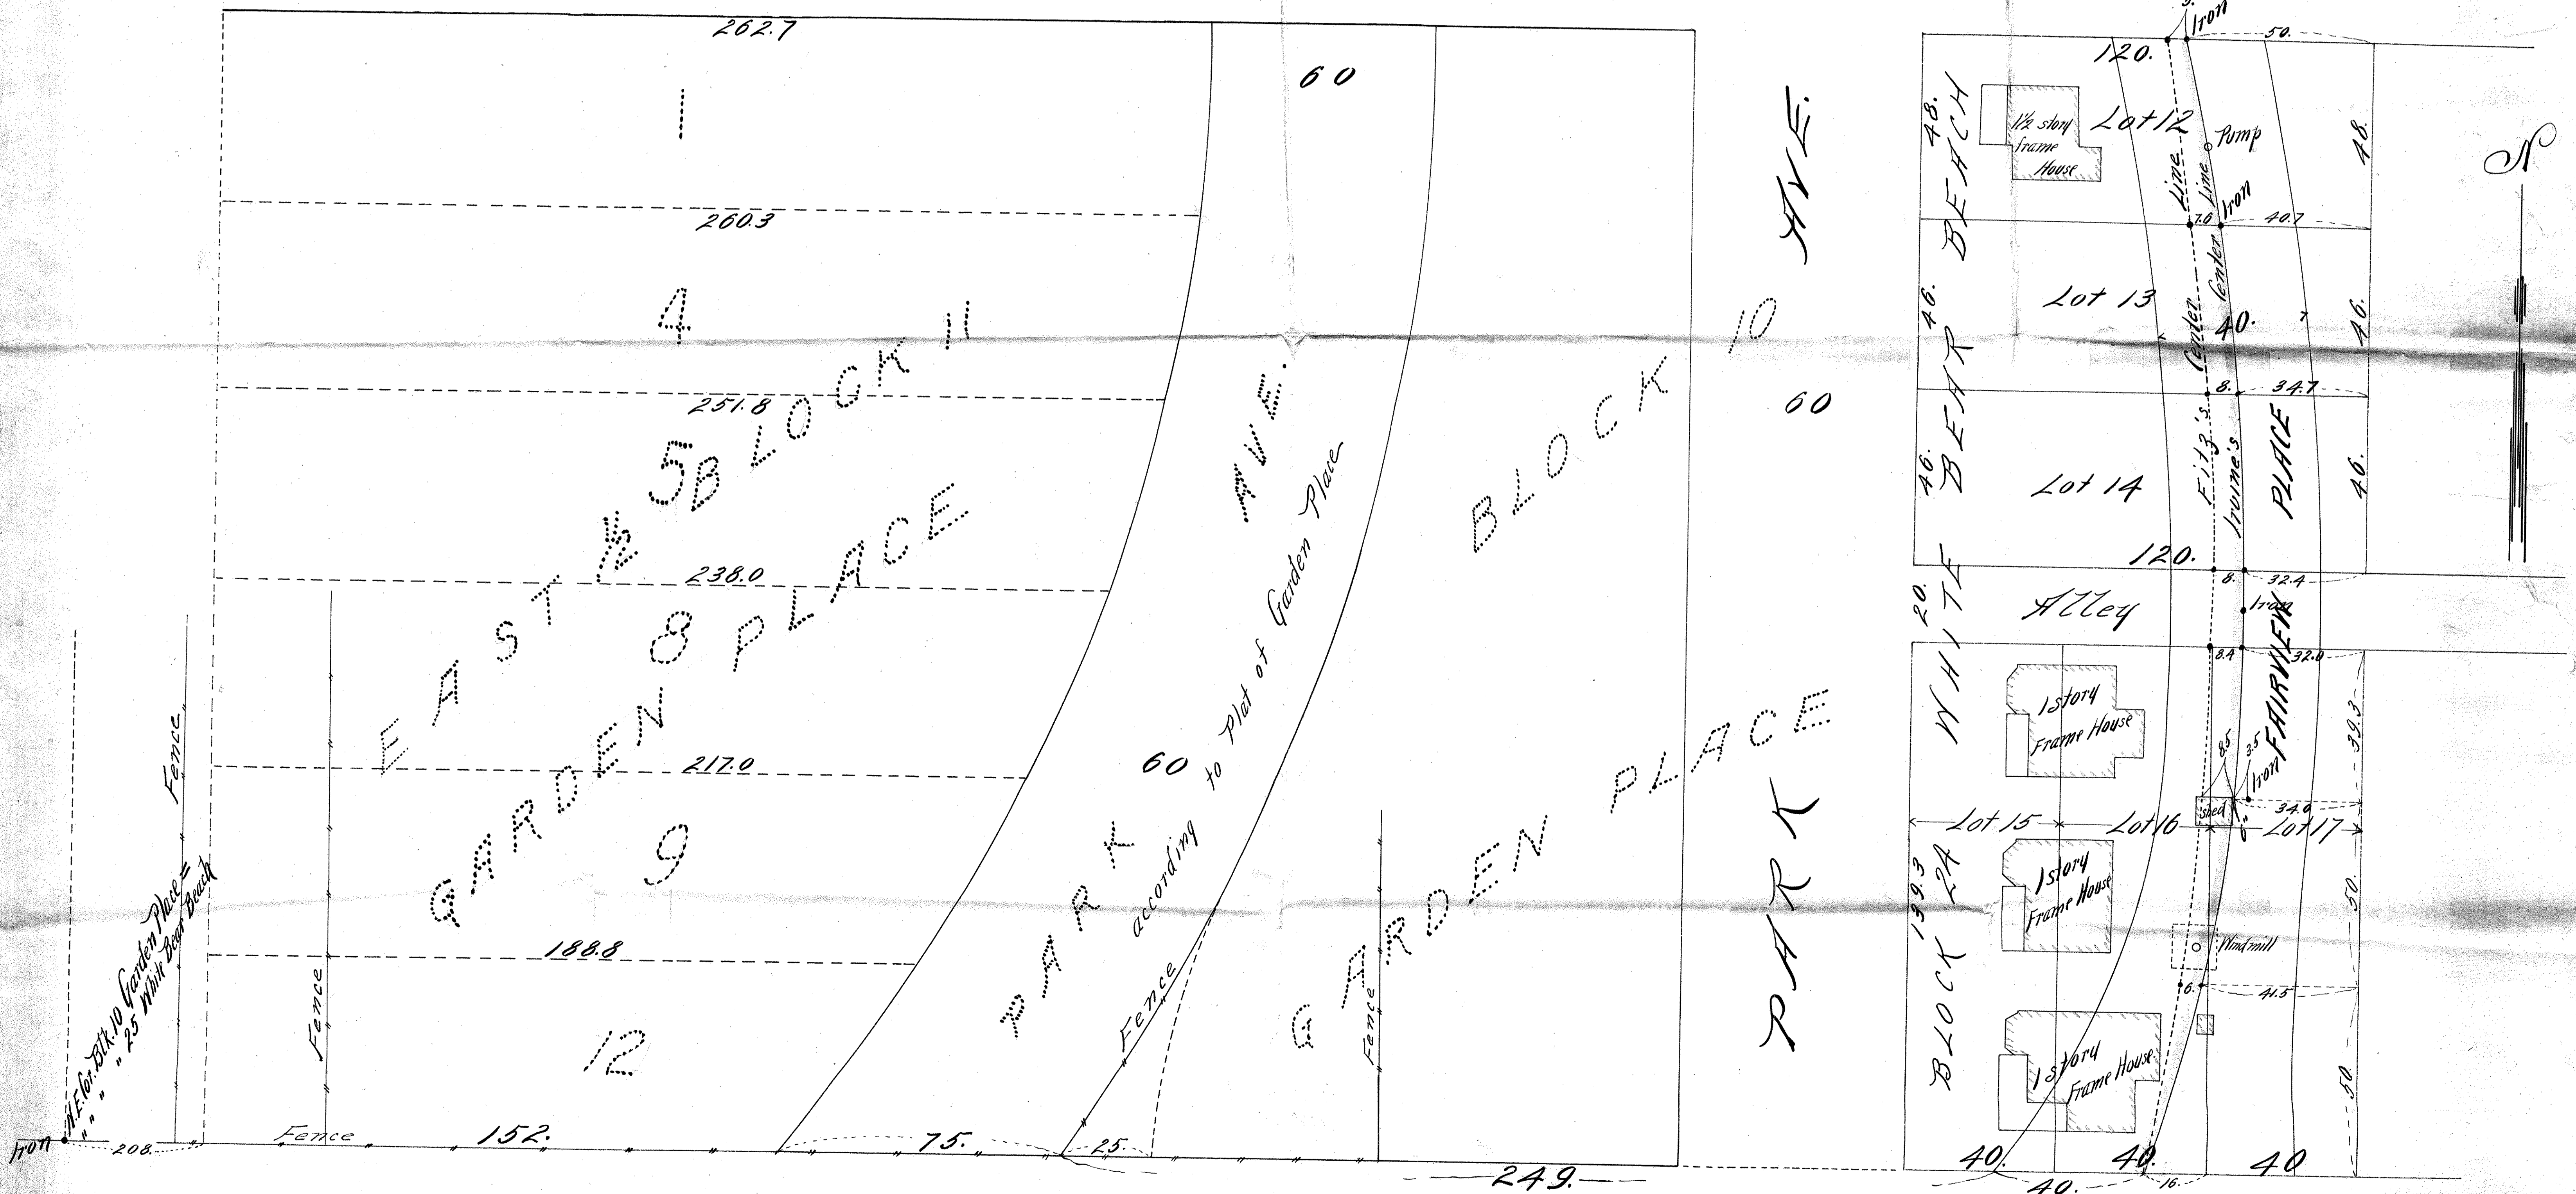

STILLWATER

AVE.