FROM THE OFFICE OF

CHARLES O. GEORGI COMPANY

2215 West County Road B Saint Paul, Minnesota 55113

REGISTERED CIVIL ENGINEER AND LAND SURVEYOR

Certificate of Survey

I Hereby Certify that this plat shows a building location survey made by me on the property described on this plat, and that all locations, have been correctly shown.

Date November 1974

Scale 1" = 30' By .....
REGISTERED LAND SURVEYOR

rveyed for: Robert W. Johnson

escription: (as furnished)
All of Lot 5, except the Easterly 17½** feet thereof, in Block 1, Woodbury and Case's Addition to St. Paul, according to the plat thereof on file and of record in the office of the Registor of Deed of said Ramsey County, also the Easterly ½ of what was Formerly Harvard Street, heretofore vacated by the City of St. Paul, and abutting upon said Lot 5, also all of Lot D in said Block 1, abutting upon and lying immediately Northerly of the premises hereinabove described, subject, however, to the following: All of said portion of said Lot D hereinabove described is subject to any lawful limitations thereon contained in the various instruments by and through which said Grantor derived his title to said Lot D, and also reserving the right to establish drive way over all or any part of the Westerly feet of that portion of Harvard Street, vacated herein above described.

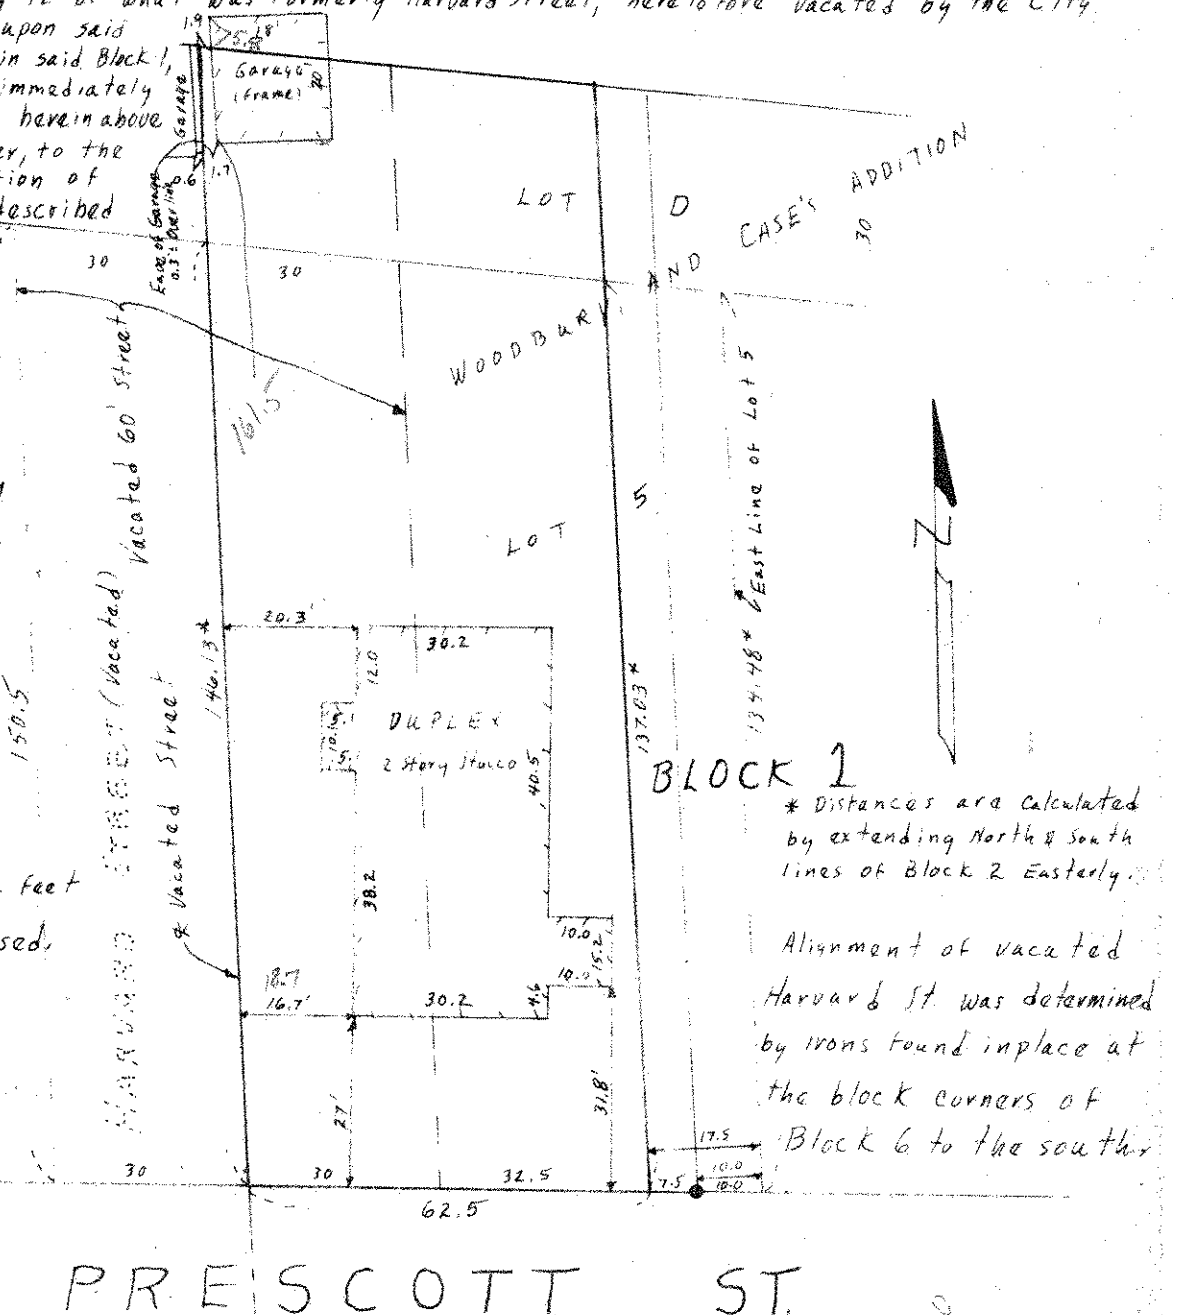

* Distances are calculated by extending North & South lines of Block 2 Easterly.

Alignment of vacated Harvard St. was determined by irons found inplace at the block corners of Block 6 to the souther

ected Deed from 17½ feet
o feet is being processed.

SCANNED ON