


PRESCOTT ST.

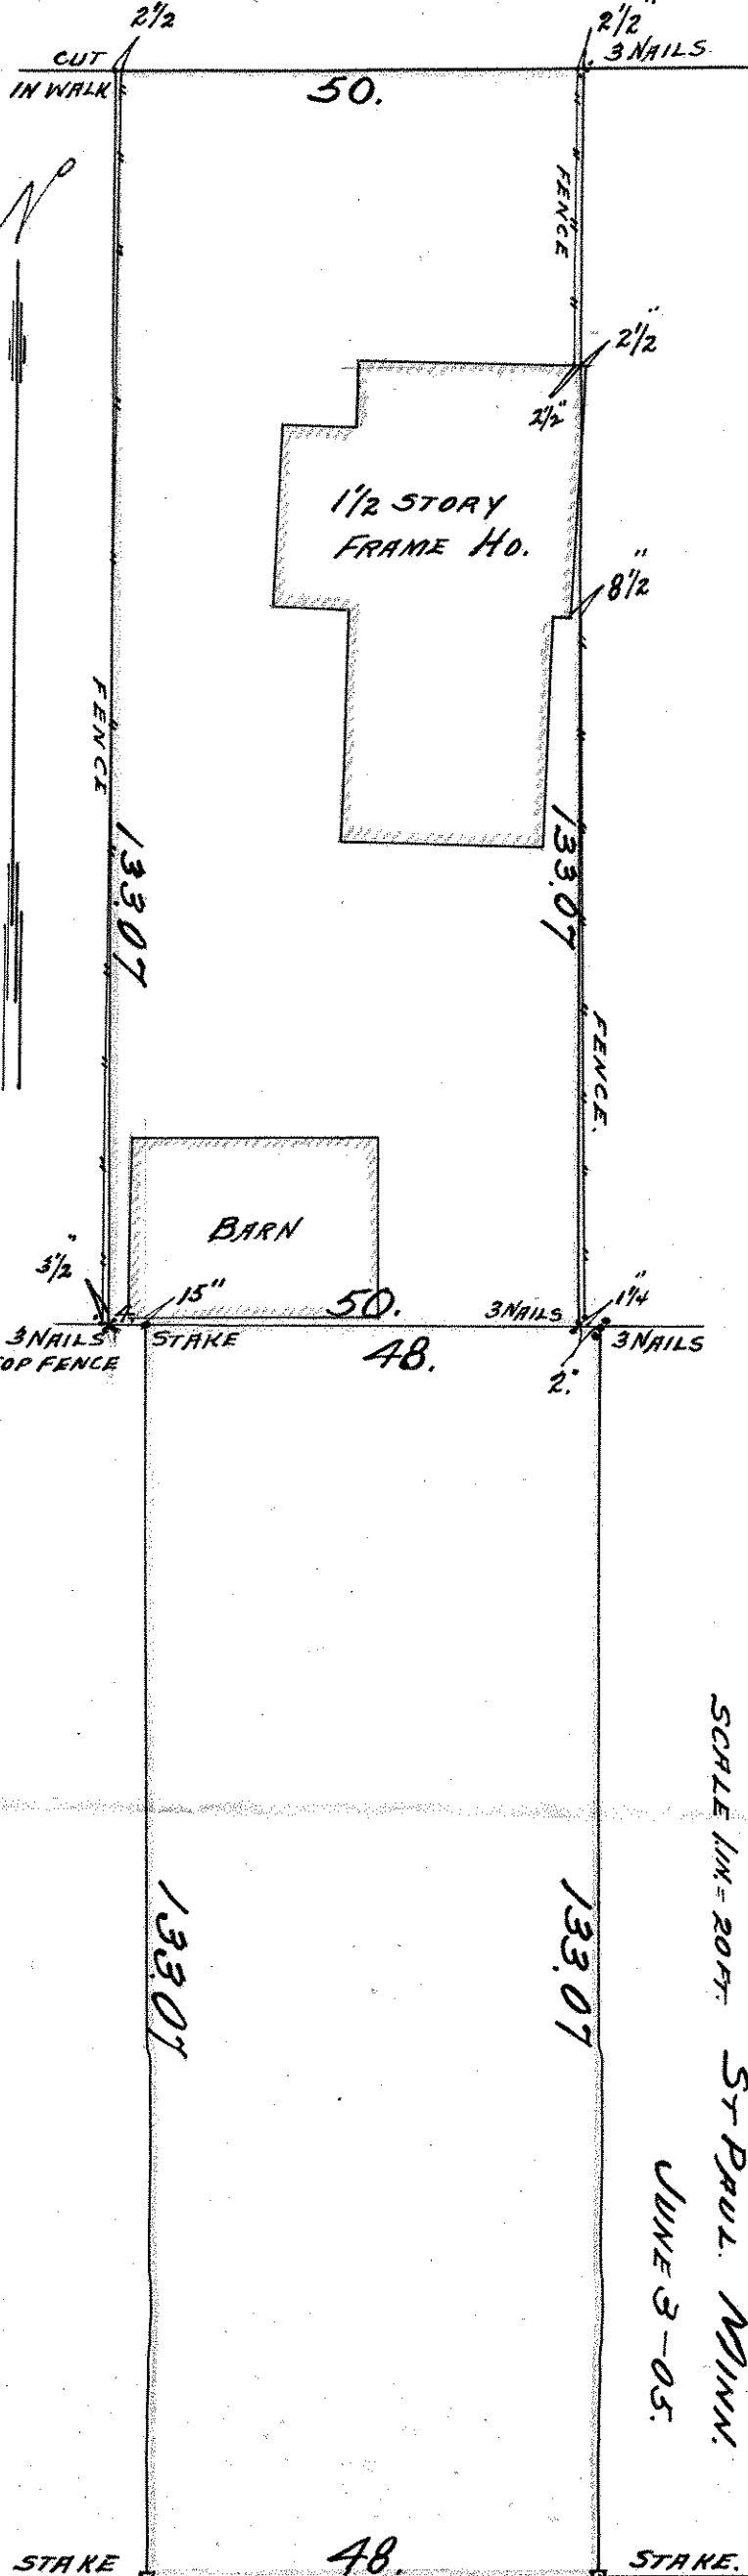

LOTS 2 & 13 BLOCK 4.
WOODBURY & CHASE'S ADD.

JOHN B. IRVINE, SURVEYOR.
ROOM 508 GLOBE BLDG.
SCALE 1/4" = 20 FT. ST. PAUL, MINN.
JUNE 3-05.

MIDWAY AVE.