

LOT'S 1-2-3&4.

ANNA M. REGNERS SUB.


1/4 3 WOODBURY & CASE ADD.

JOHN B. IRVINE, SURVEYOR.

ST. PAUL MINN.

JUNE 18TH 08.

Scale 30 ft. per inch.

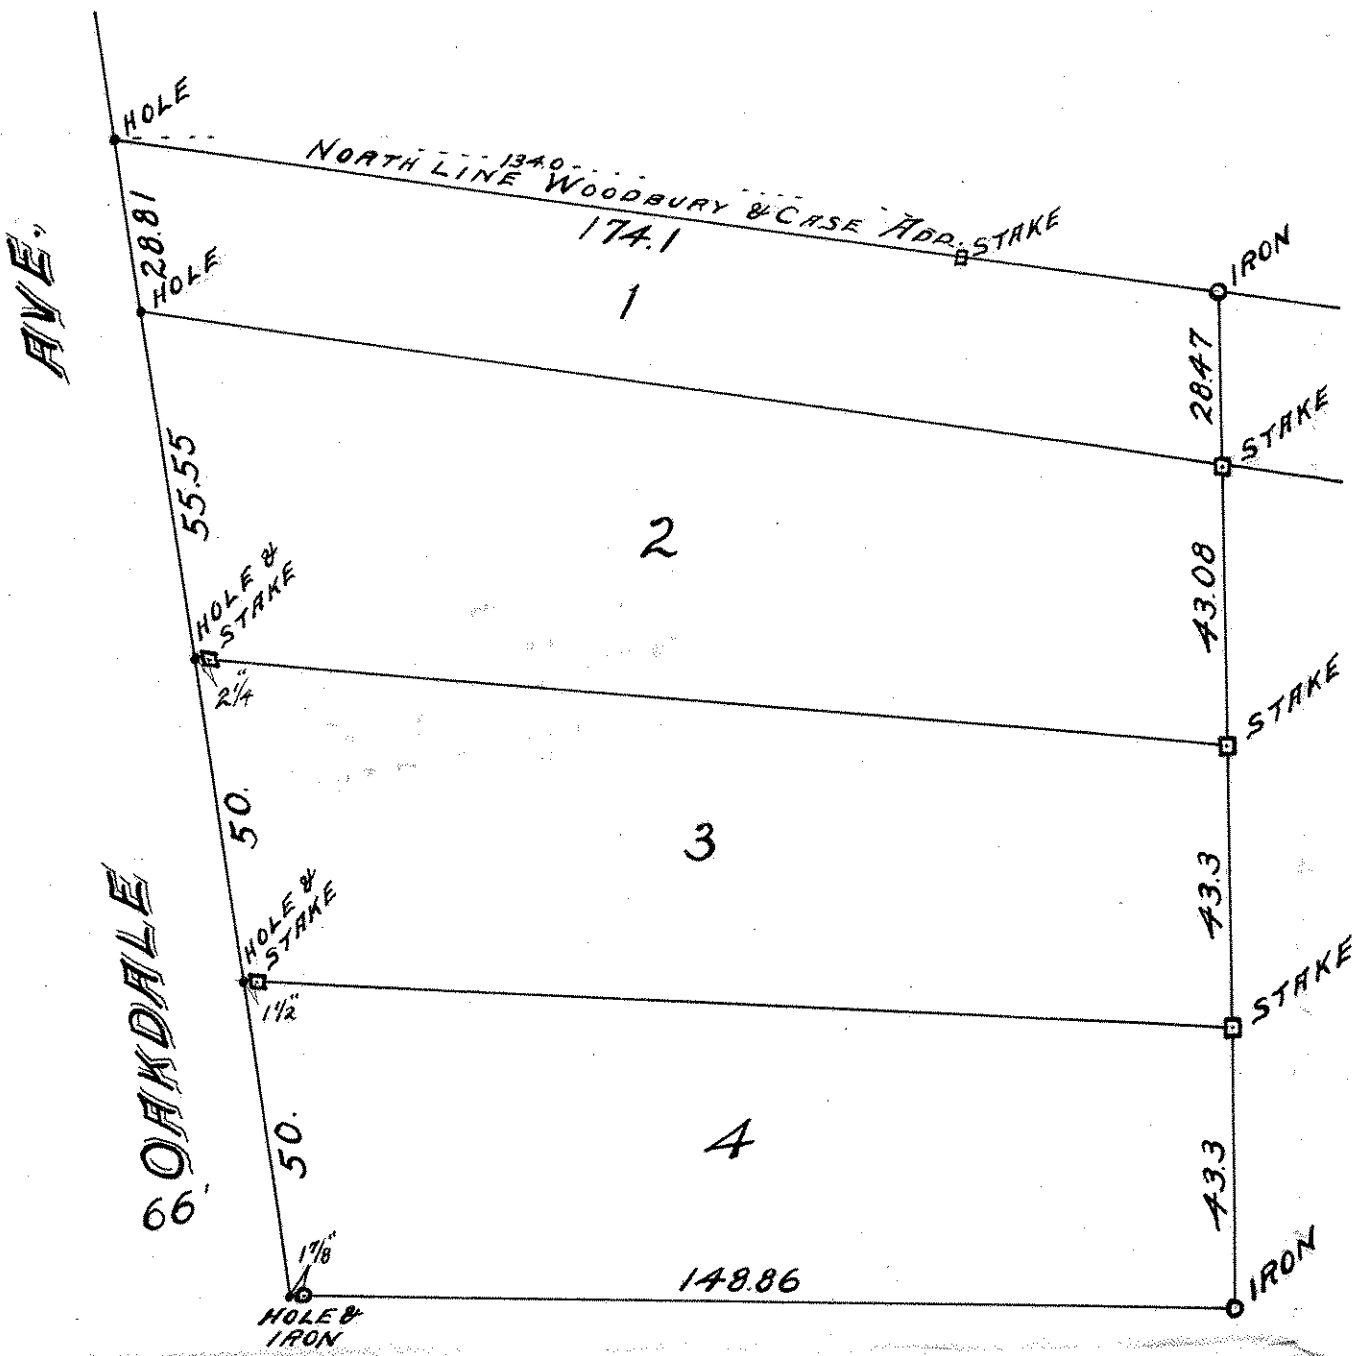

RECORDED BY