THE WESTERLY 20¾ FT. OF LOT 1 &
THE EASTERLY 19¼ FT. OF LOT 2
BLOCK 2.
WOODBURY & CASE ADD.

JOHN B. IRVINE. SURVEYOR.
ROOM 416 GLOBE BLDG.
ST PAUL MINN.
JULY 16-06.
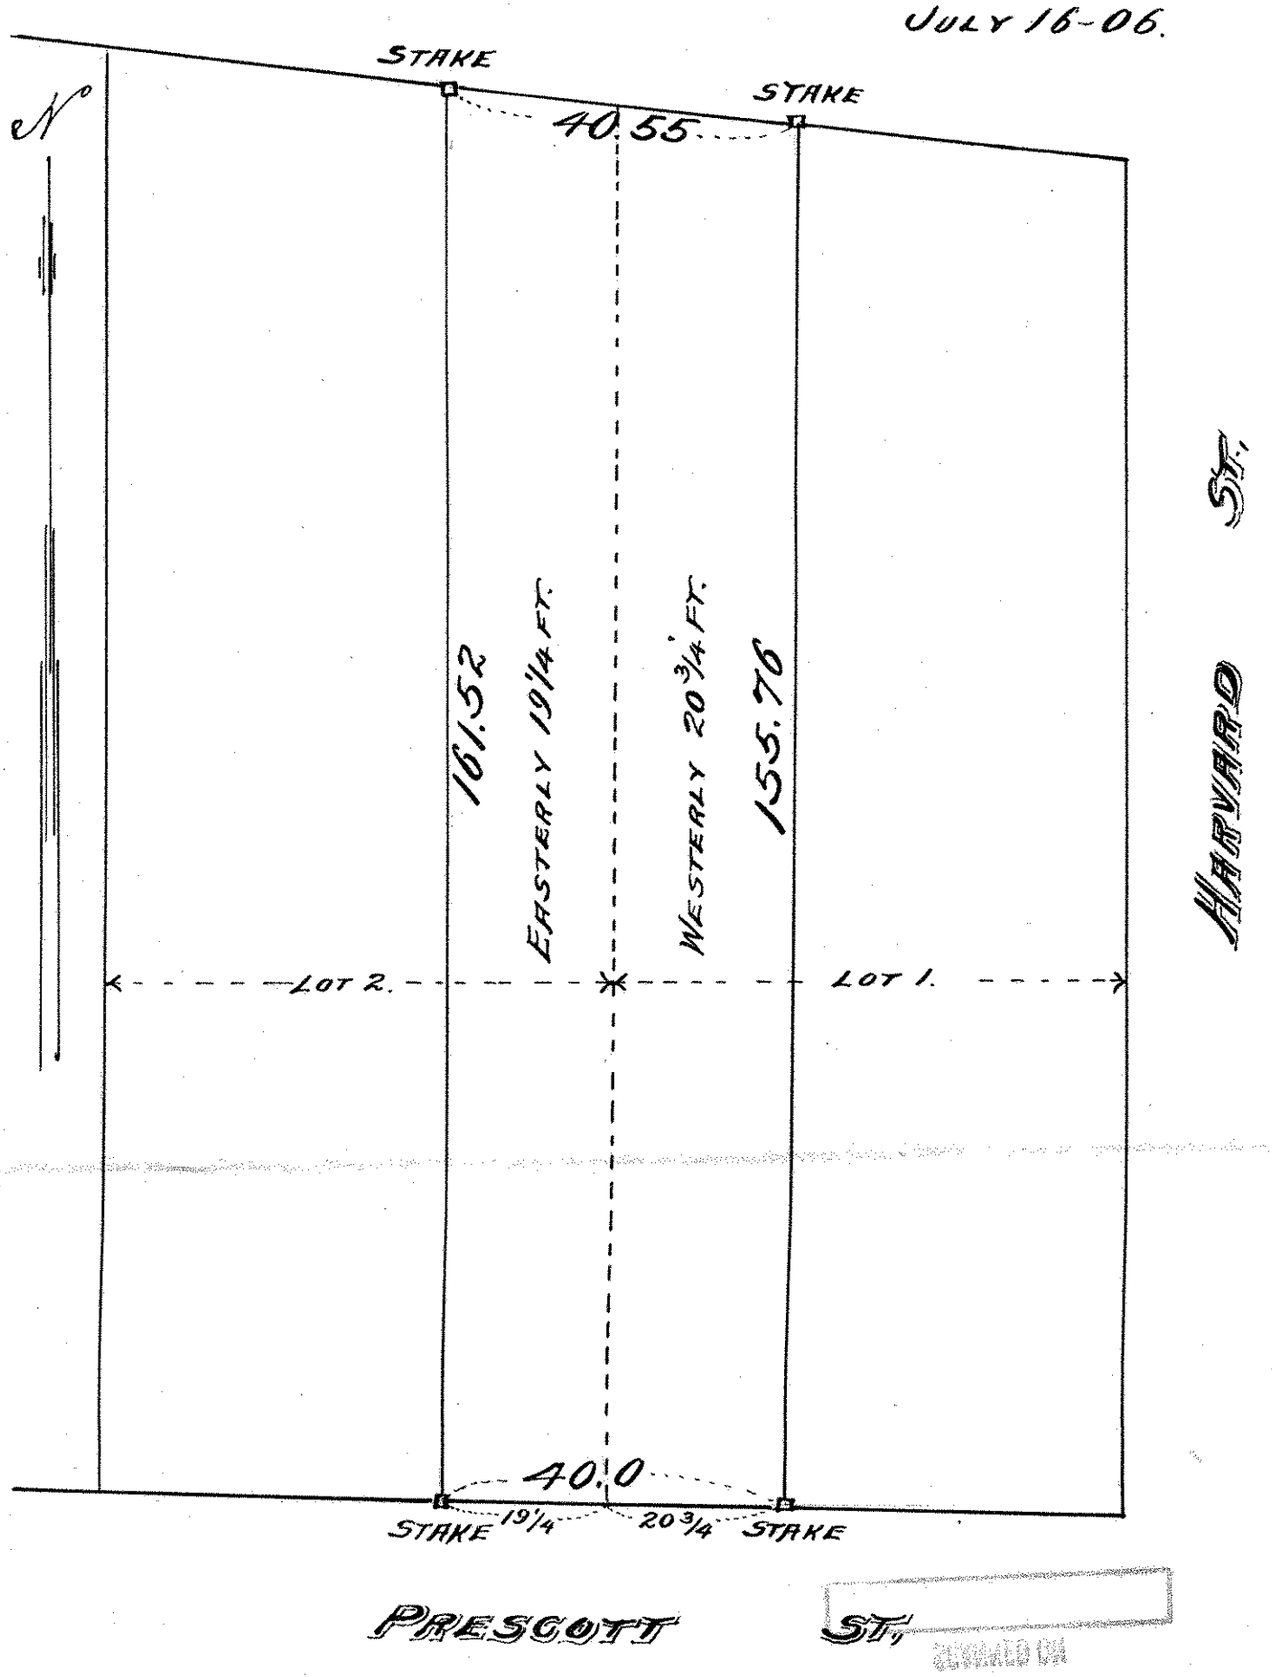
SCALE 1 IN. = 20 FT.