


WEST 50. FT. OF EAST 200. FT. OF NORTH  
123. FT. OF BLOCK 16 WOODBURY &  
CASE'S ADD.  
SURT. MAR. 20<sup>TH</sup> 1903 FOR OTTO LUX  
20 FT. pr. inch

BUNKER ST.  
60

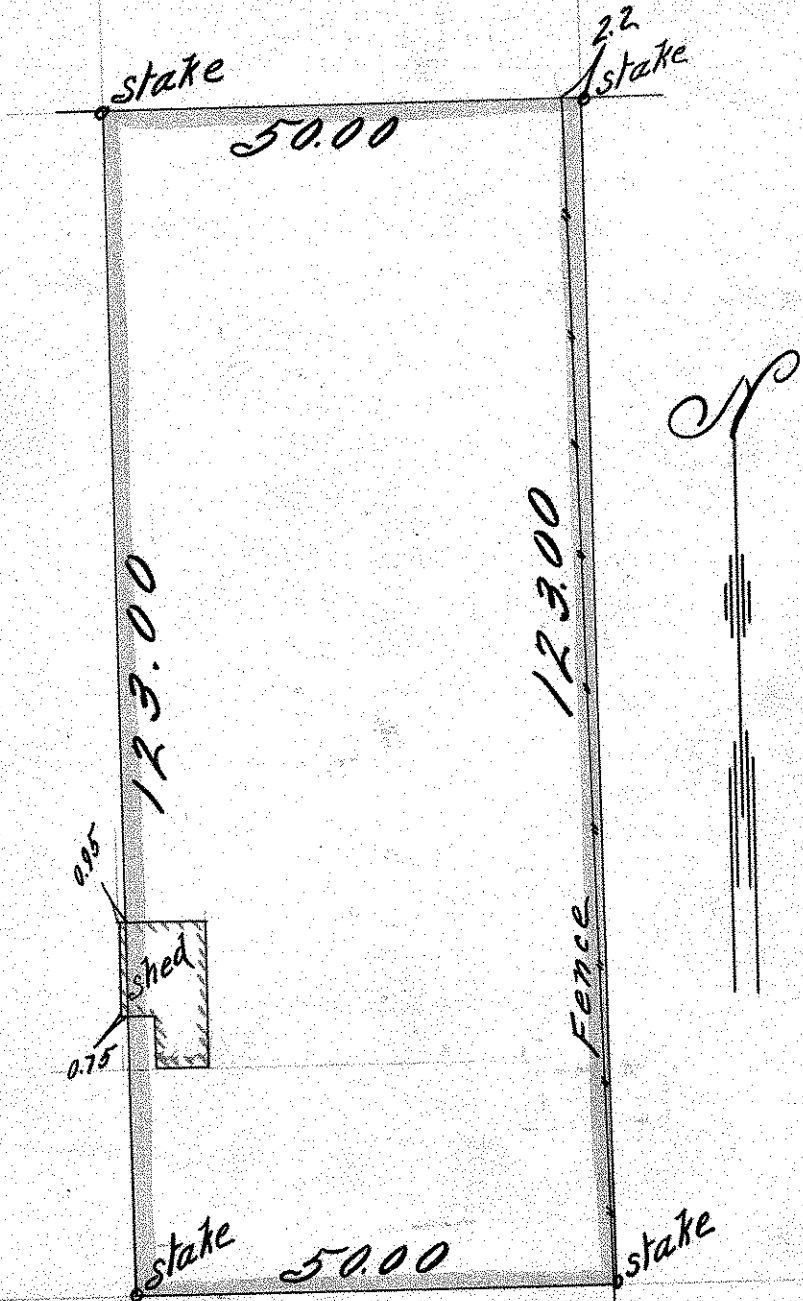

B.53.P67

