
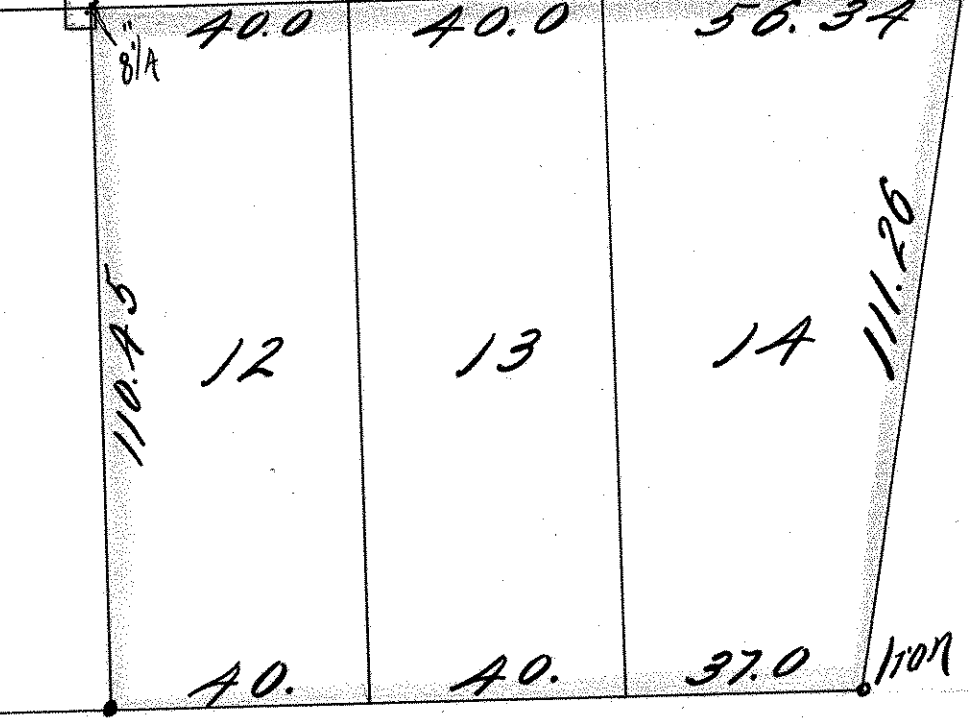
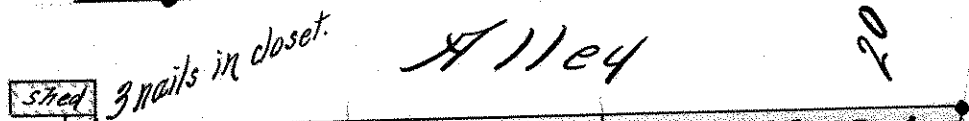


STILLWATER AVE.

LOTS 1, 2, 3, 12, 13 & 14 BLOCK 35
WHITE BEAR BEACH

30' = 1" = offset

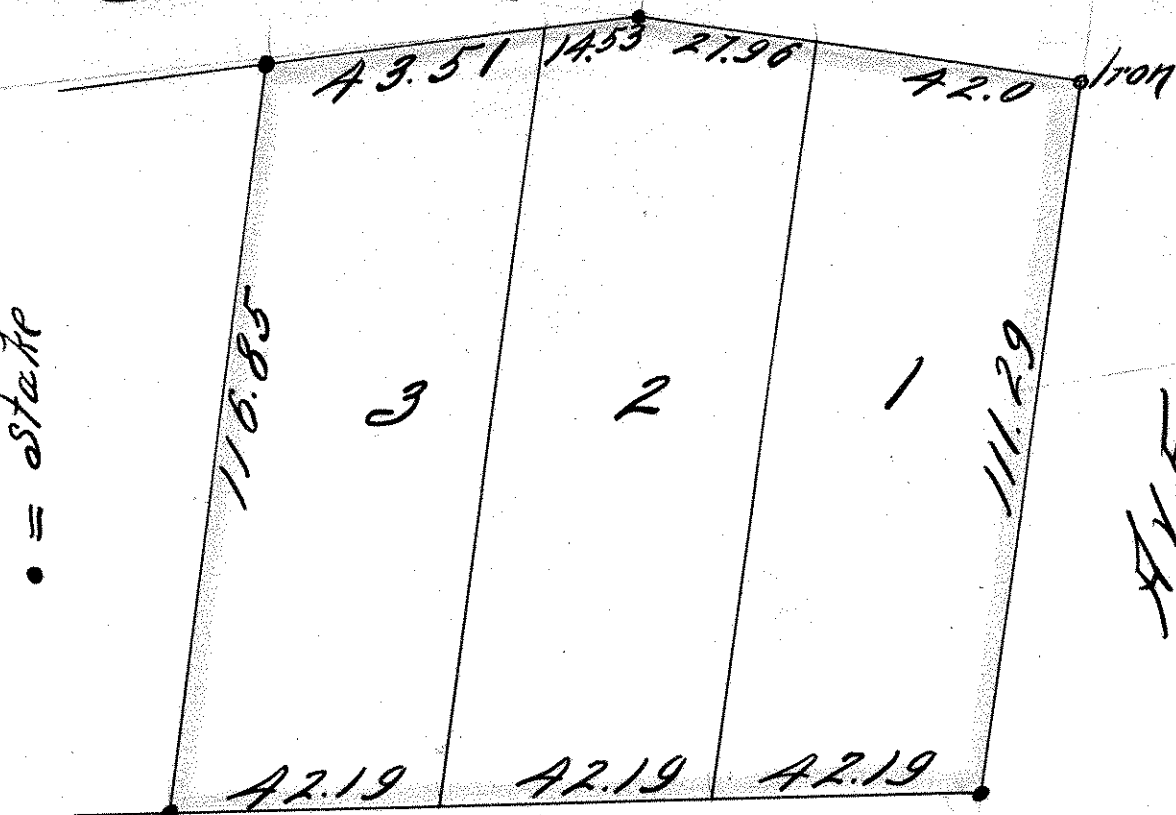

ALLEY

PORTLAND

BOULEVARD

Aug. 1 '04 Kuhlo.

