


SURVEY FOR MISS E. CUMMINGS  
WHITE BEAR BEACH - 10-11-28

By P.R. Banister.  
Civil Engr.  
69-7th Ave.  
North St. Paul  
Phone N.5.P.407

Scale - 1" = 200'

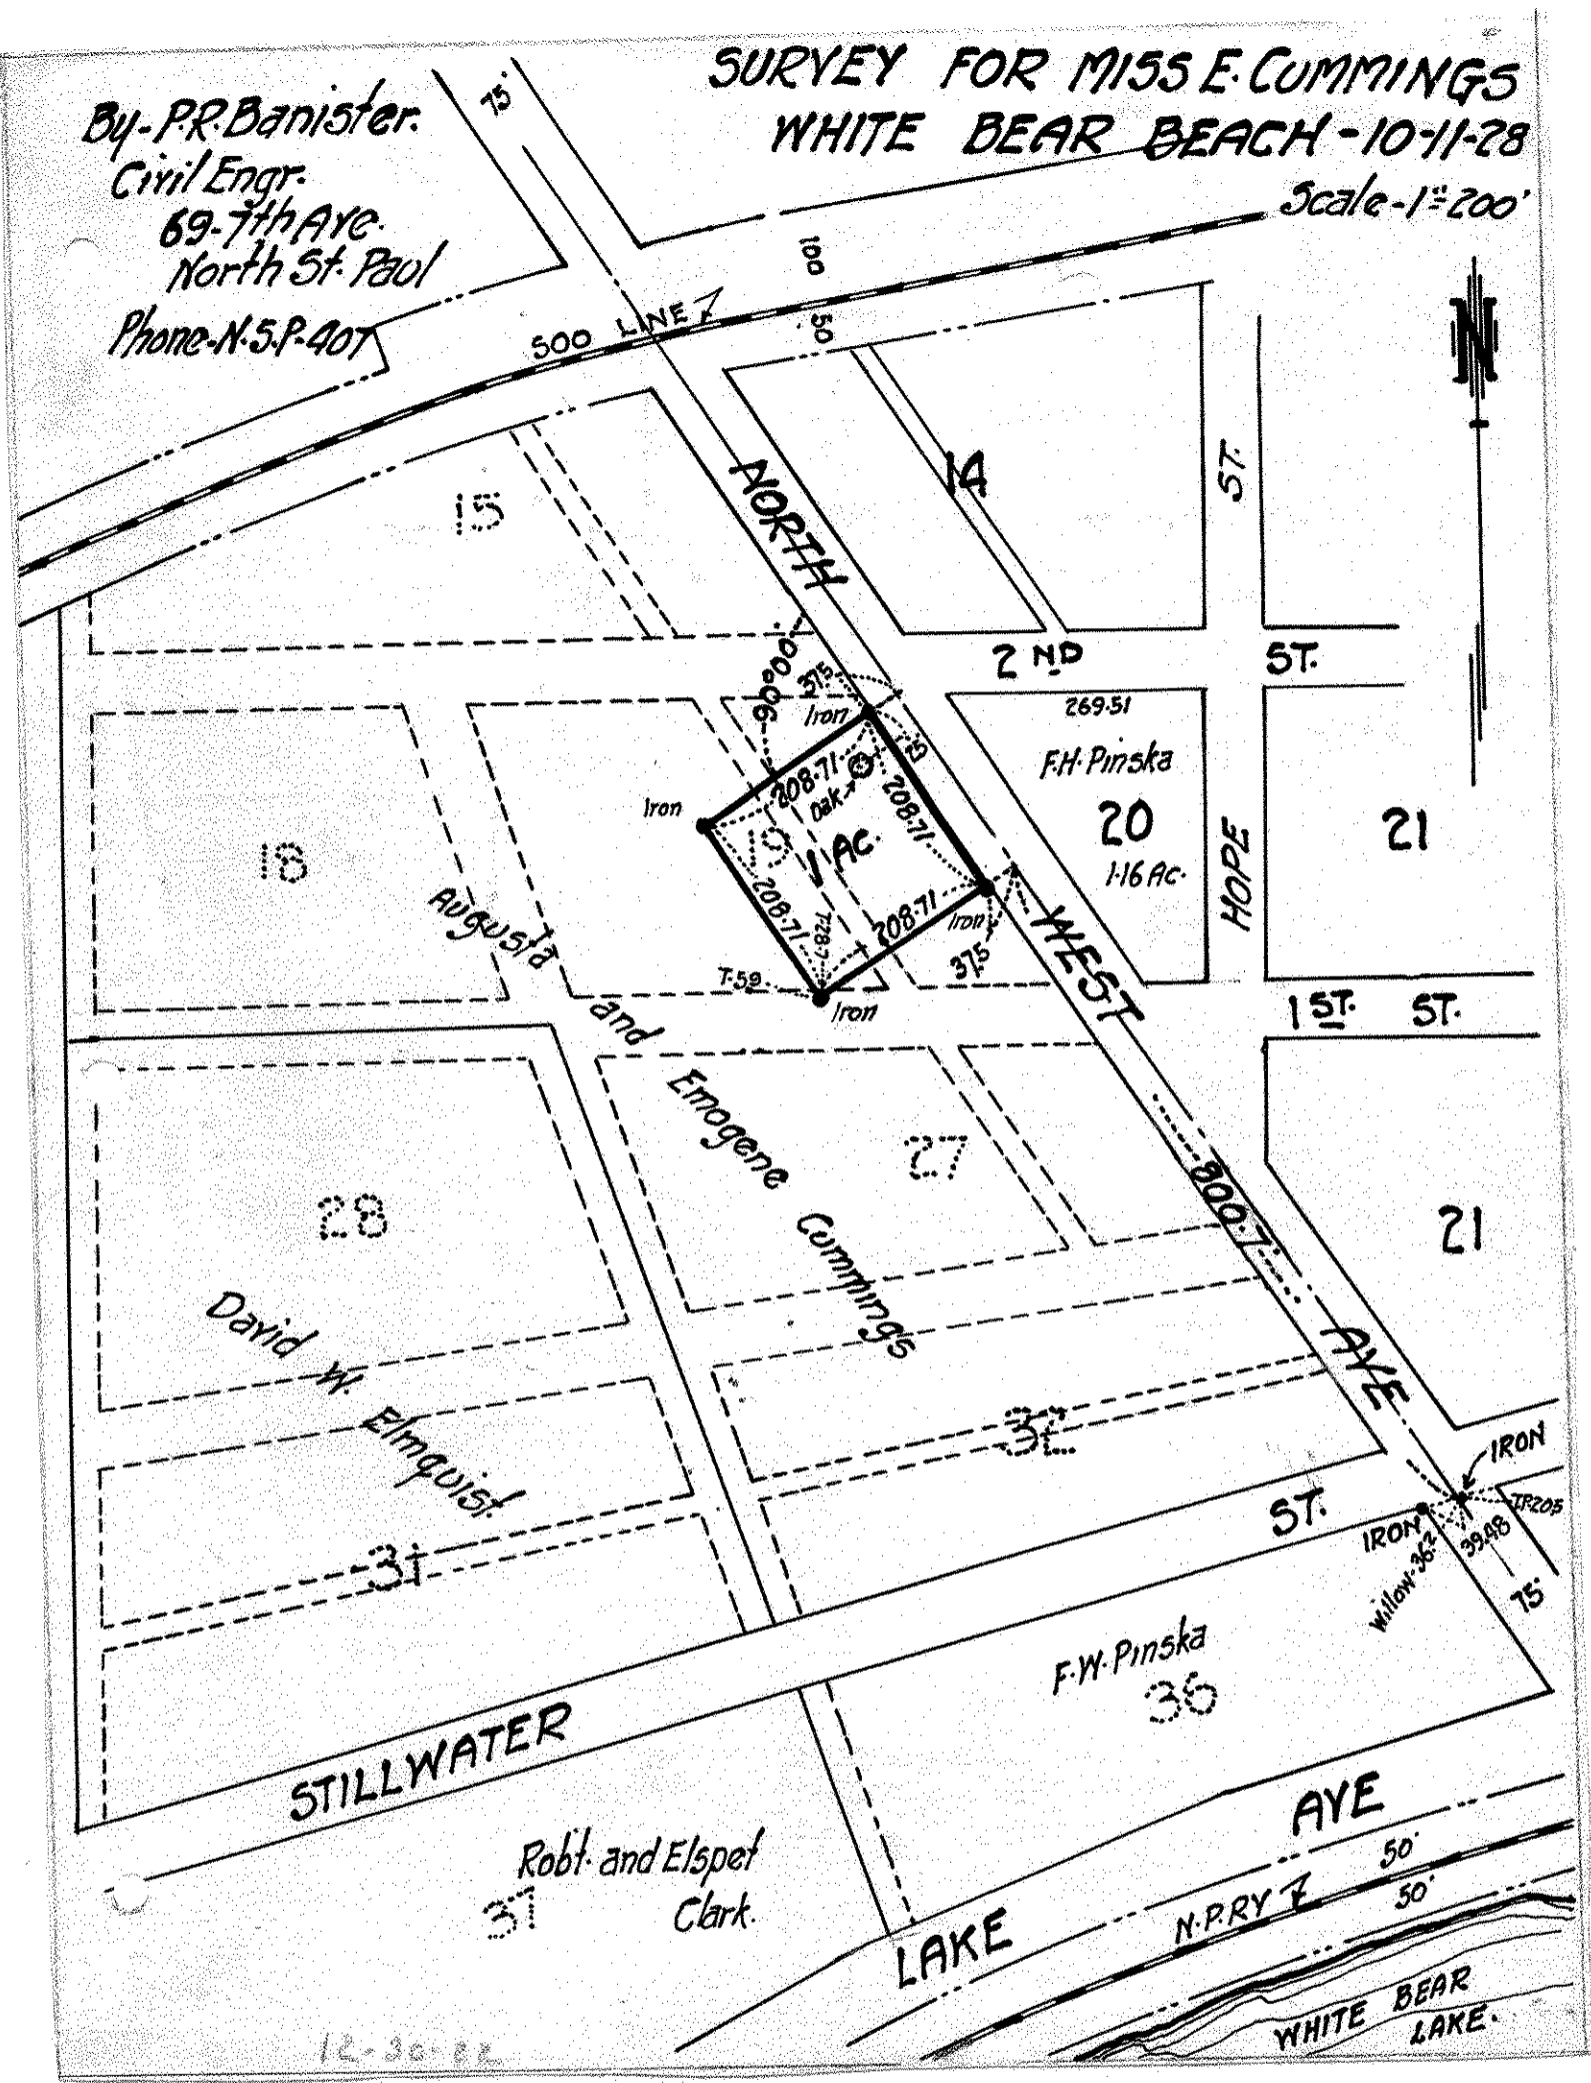

12-30-28