


14 20 11
LOT 1. BLOCK 40.
WHITE BEAR.

JOHN B. IRVINE, SURVEYOR.
 408 GLOBE BLDG.
 ST. PAUL, MINN.
 AUG. 8-1911.
 SCALE 20 ft. per inch.

SIXTH ST.

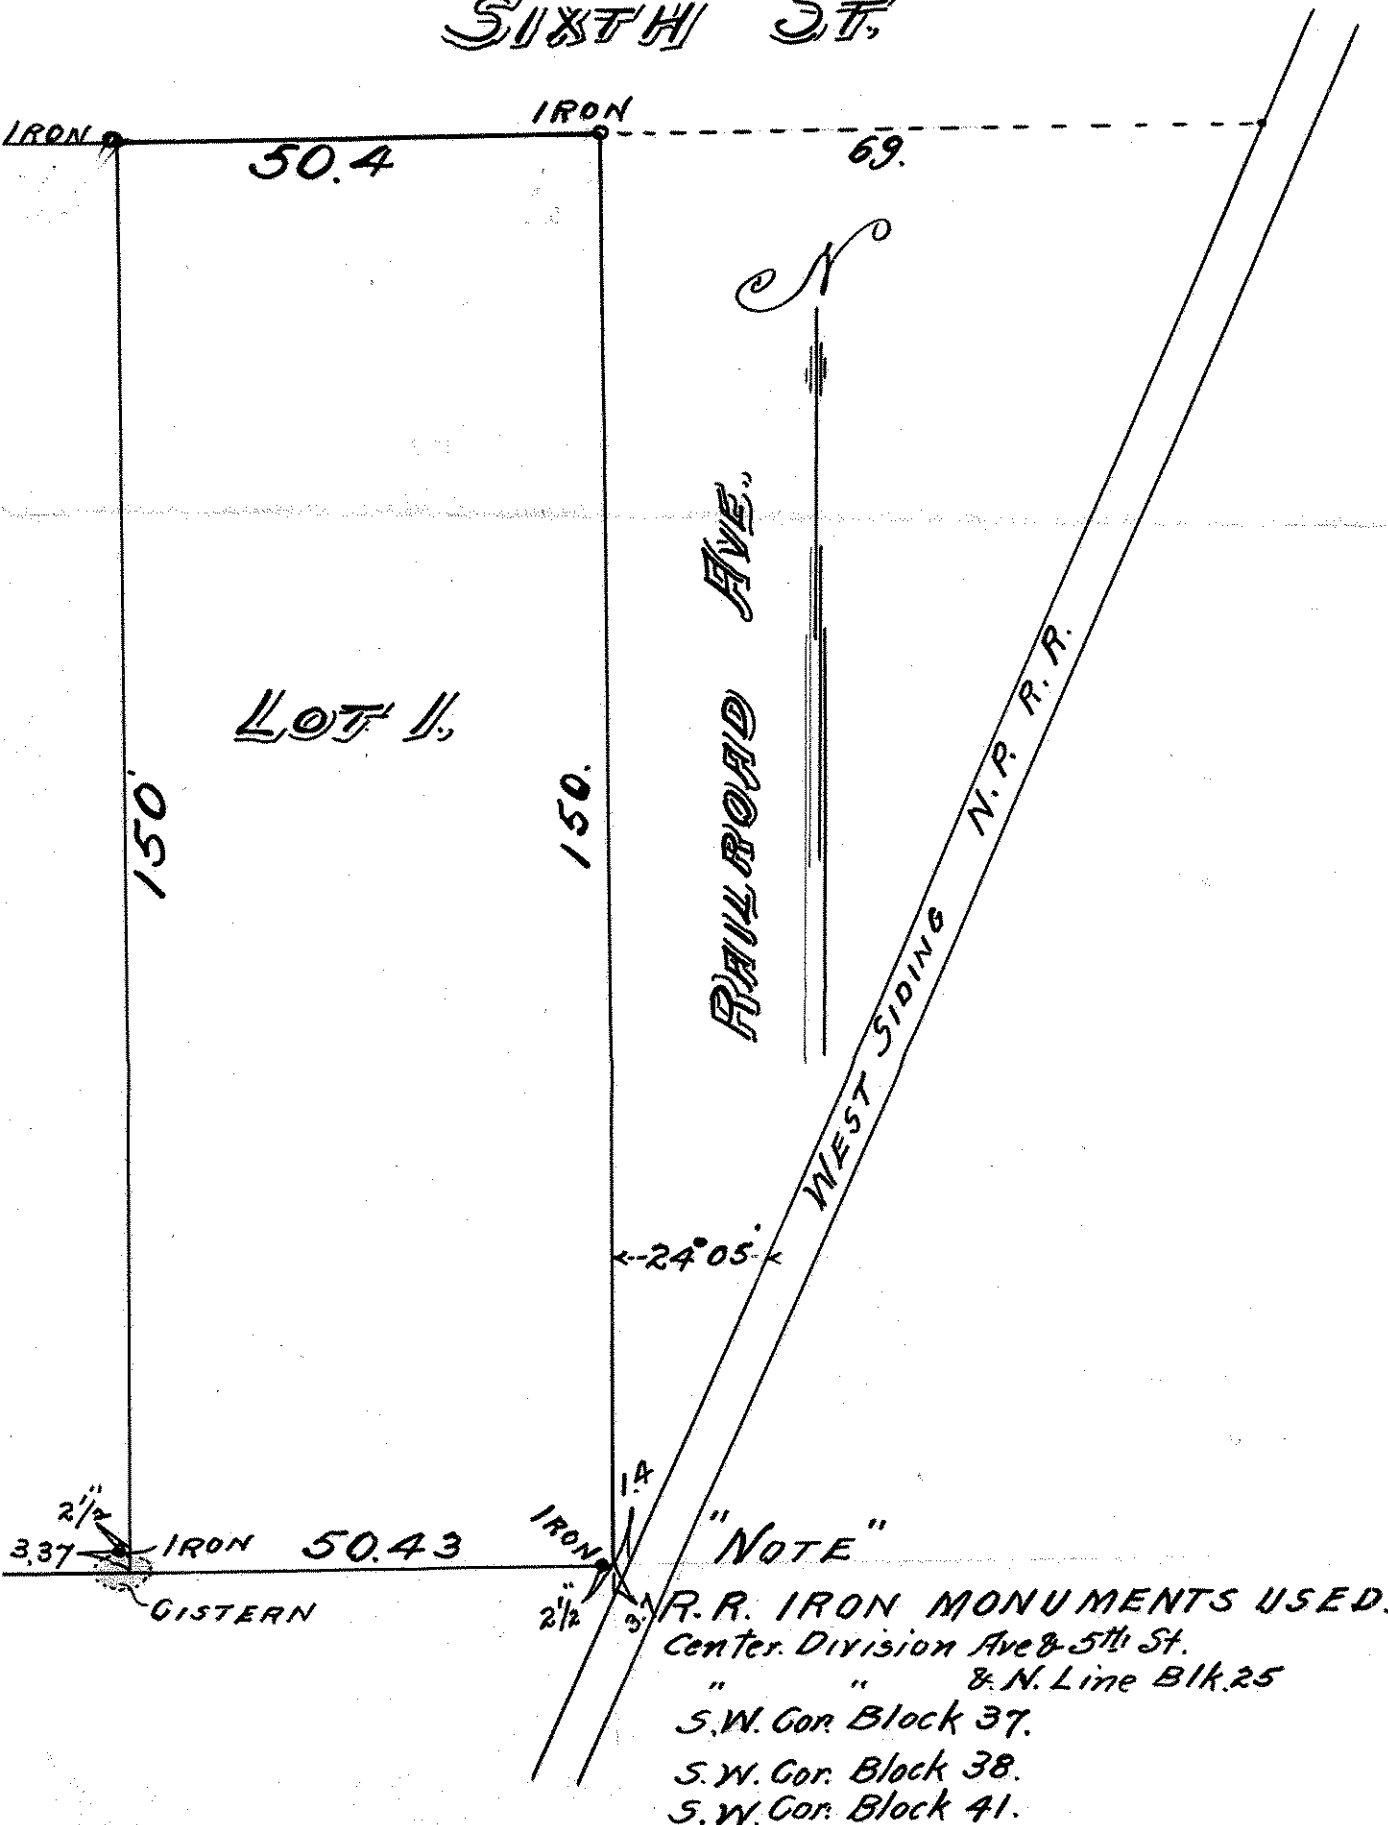

"NOTE"
 R.R. IRON MONUMENTS USED.
 Center Division Ave & 5th St.
 " " & N. Line Blk. 25
 S.W. Cor. Block 37.
 S.W. Cor. Block 38.
 S.W. Cor. Block 41.