

Certificate  
of Survey

FROM THE OFFICE OF

CHARLES O. GEORGI COMPANY

2215 West County Road B

Saint Paul 13, Minnesota

REGISTERED CIVIL ENGINEER AND LAND SURVEYOR

I Hereby Certify that this plat shows a survey made by me of the property described on this plat, and that the corners are correctly placed as shown, and that all locations have been correctly shown.

Surveyed For Mr. L. Pearlman

Date May 1959

Scale 1" = 40'

By Charles O. Georgi  
REGISTERED LAND SURVEYOR


Description:

The South 50 feet of Lot 6  
Block 63  
White Bear  
White Bear, Minn.



BEAR


SCANNED ON

 

FIRST ST. 60'

150'

CLARK AVE.

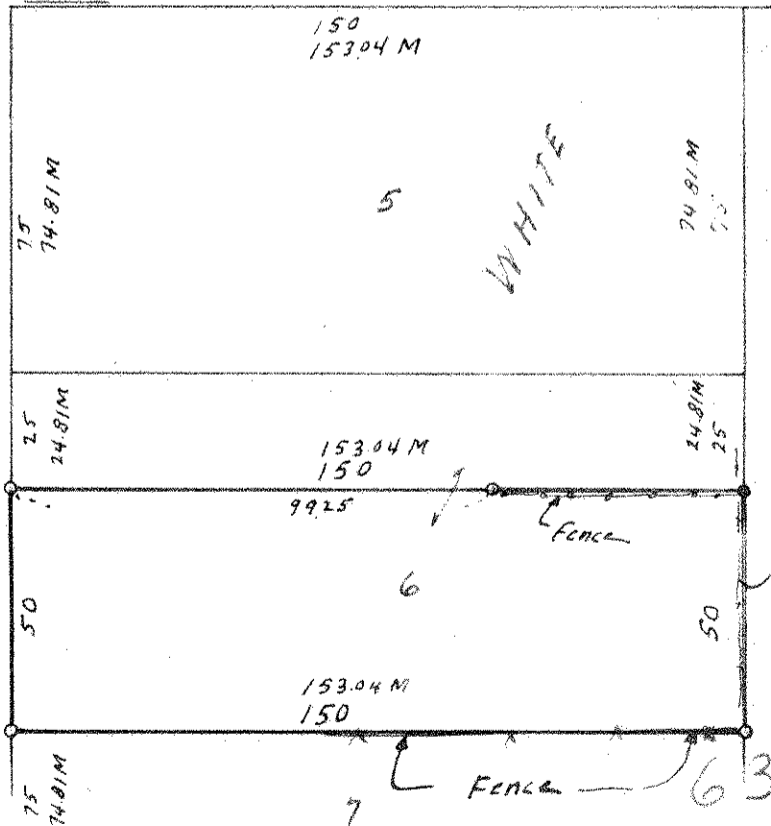

- o Denotes Iron Monument
- M - Denotes Pro-rated measure for Block Excess or Shortage.