


PLAT OF SURVEY

OF PROPERTY OF P. J. Haggerty.
DESCRIBED AS FOLLOWS Lot 42, Whitacre, Brisbin and Mullins Sub.
No. 291 Forbes Avenue, St. Paul, Minn.

SCALE: 1 INCH 20 FEET
○ Indicates Iron

T. J. WELCH, REGISTERED SURVEYOR
738 SURREY AVENUE, ST. PAUL, MINN.

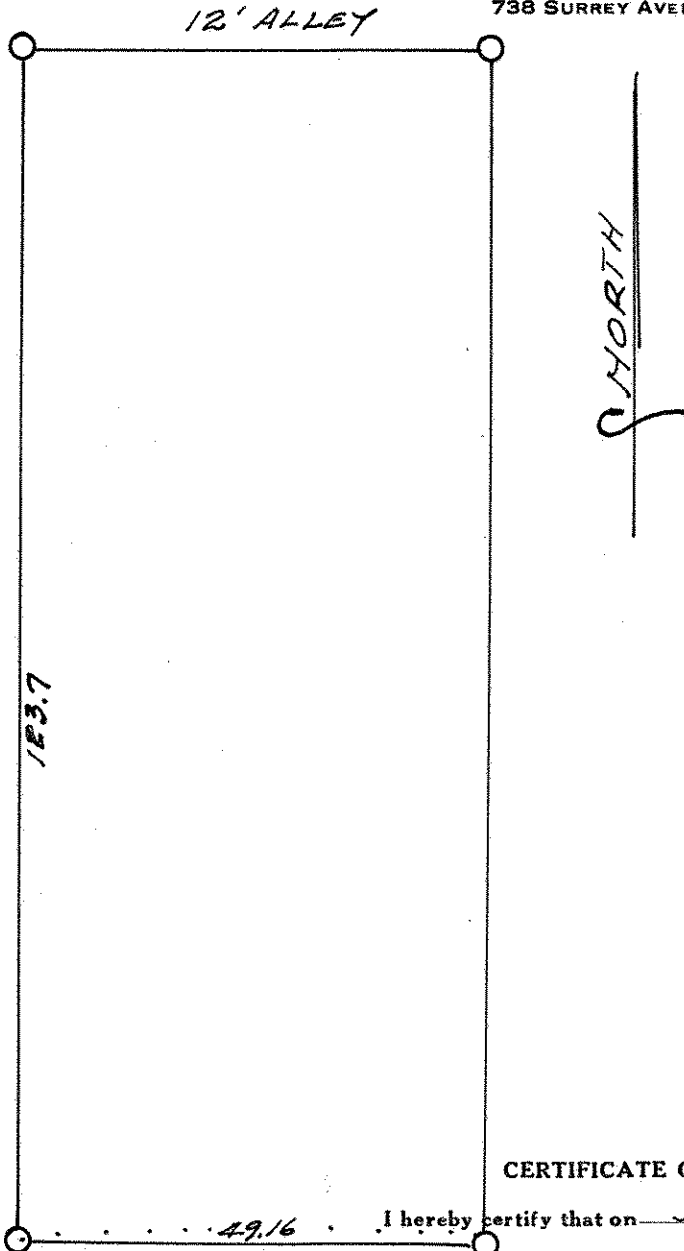

CERTIFICATE OF SURVEY

I hereby certify that on June 9, 1943.
I surveyed the property described above and that the above
plat is a correct representation of said survey.

T. J. Welch

