63
317 25

Certificate of Survey

FROM THE OFFICE OF

CHARLES O. GEORGI COMPANY

2215 West County Road B Saint Paul, Minnesota 55113

REGISTERED CIVIL ENGINEER AND LAND SURVEYOR

I Hereby Certify that this plat shows a survey made by me of the property described on this plat, and that the corners are correctly placed as shown, and that all locations have been correctly shown. 128.03 and 127.5

Surveyed For Earl Eng.

Date July 1968

Scale 1" = 100'

By Charles O. Georgi
REGISTERED LAND SURVEYOR

Description:

The East 158.03 feet of the West 318.03 feet of the North 90 feet of Lot 55 Wilkin and Heyward's Outlots except part taken for Norton St.

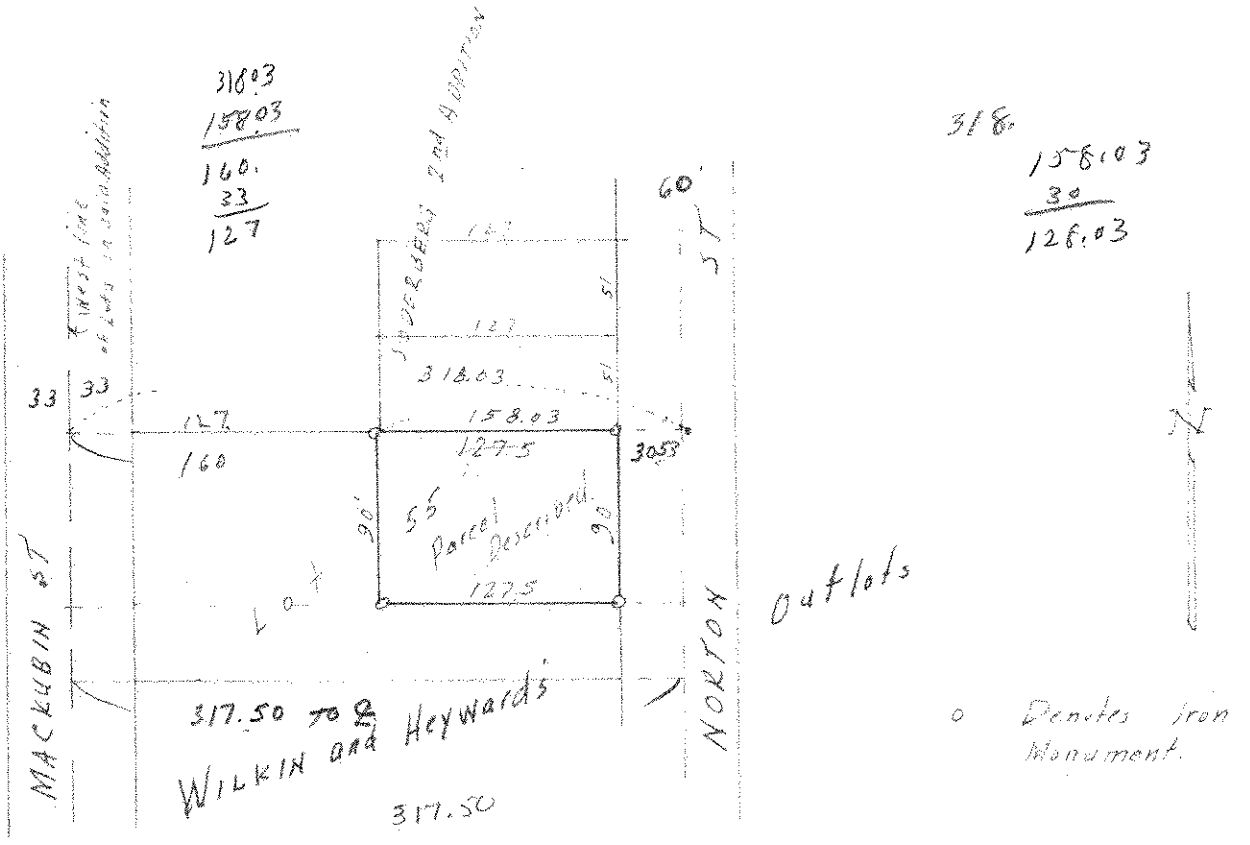

SCANNED ON