FROM THE OFFICE OF

CHARLES O. GEORGI COMPANY

2215 West County Road B Saint Paul, Minnesota 55113

REGISTERED CIVIL ENGINEER AND LAND SURVEYOR

Certificate of Survey

I Hereby Certify that this plat shows a survey made by me of the property described on this plat, and that the corners are correctly placed as shown, and that all locations have been correctly shown.

C.O.G. Nov. 29, 1976 Added building location, Missing iron not reset,

Feb, 1980 relocated irons, check Bldg location and added improvements

Donald W. Schmidt RLS # 10459

Jan. 19, 1976 added easement Note

Surveyed For Mrs. Cirasi - Antler Corp.

Date July 1969

Scale 1" = 30'

By Charles O. Georgi REGISTERED LAND SURVEYOR

Description:

The East 100 Feet of Lot 60 of Wilkins and Heywards Outlots, Ramsey County, Minnesota.

Note: There are no visible easements or encroachments on or across this parcel
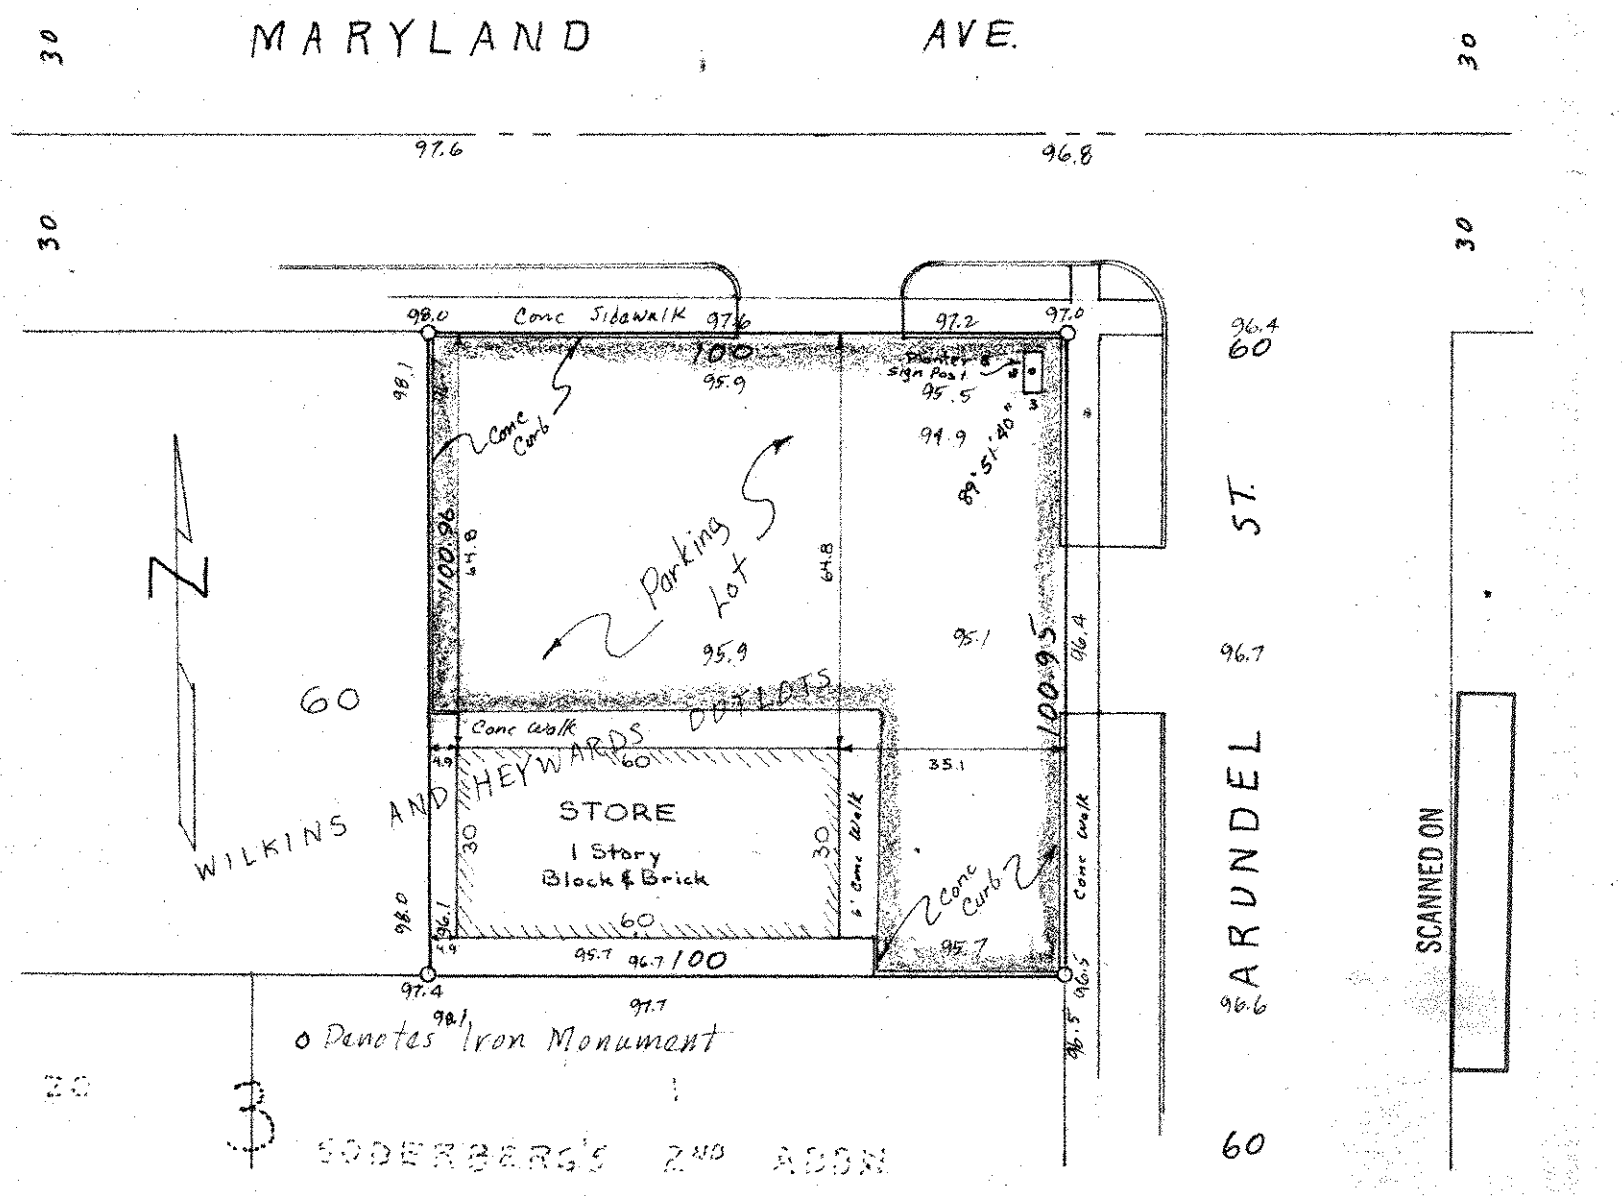
Elevations: Assumed Datum
B.M. = 100.00 Top Hyd N.E. Cor Maryland & Arundel