SW 1 28 23

FROM THE OFFICE OF

# CHARLES O. GEORGI COMPANY

2215 West County Road B Saint Paul, Minnesota 55113

REGISTERED CIVIL ENGINEER AND LAND SURVEYOR

# Certificate of Survey

Project No. Minn. A-1-7
Parcel No. 59-D 59-J 59-K
Area. 397 sq.ft. 4,246 sq.ft. 1,327 sq.ft.

*I Hereby Certify that* this plat shows a survey made by me of the property described on this plat, and that the corners are correctly placed as shown, and that all locations have been correctly shown. 3/4/75 East ½ was East ⅓

*Surveyed For* Housing Authority
*Date* March 1974
*Scale* 1" = 40'

By Charles O. Georgi
REGISTERED LAND SURVEYOR

*Description:* Parcel 59-J

The West ⅓ of lot 1, and the South ½ of the West ⅓ of lot 2 except the North 3 feet thereof, Block 3, Willes Addition to Saint Paul, Ramsey County, Minnesota.

Description Parcel 59-D
The North 3 feet of the South ½ of lot 2, Block 3, Willes Addition to Saint Paul, Ramsey County, Minnesota.

Description Parcel 59-K
The East ½ of the West ⅔ of the South ½ of lot 2 except the North 3 feet thereof, Block 3, Willes Addition to Saint Paul, Ramsey County Minnesota.

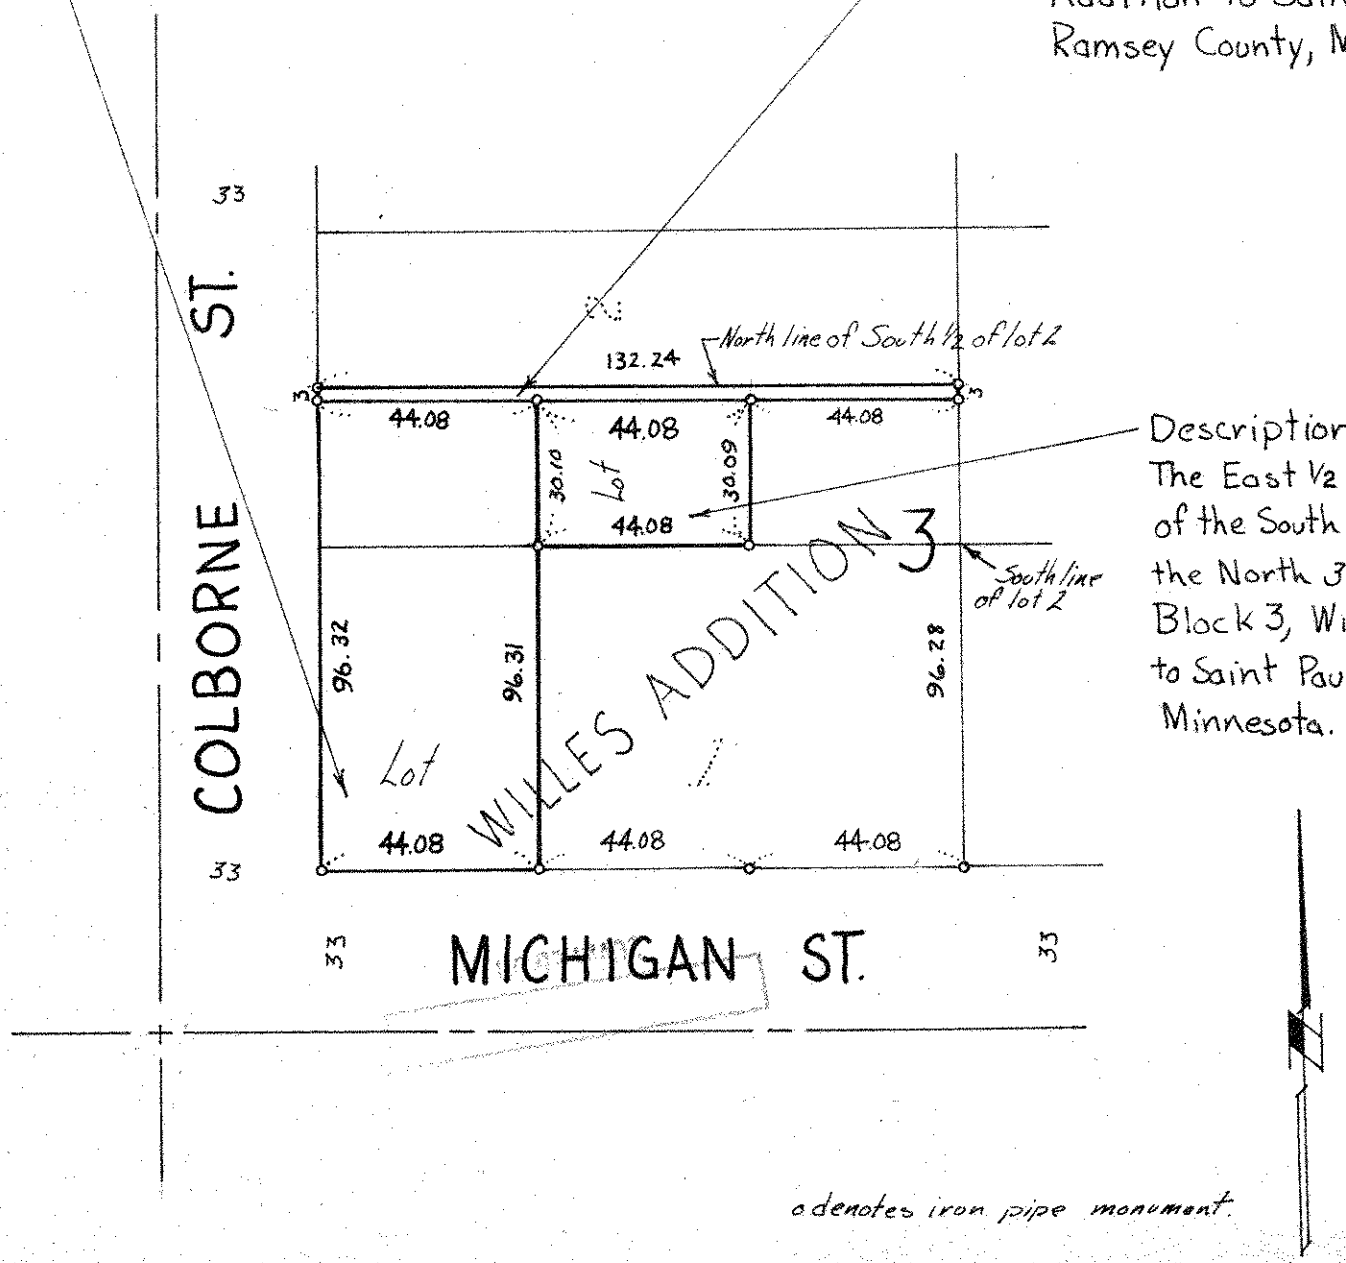


o denotes iron pipe monument.