


PART OF LOTS 3 & 4, BLK. A  
 WILLE'S ADD.  
 20' = 1"

Sur. Sep. 12<sup>th</sup> '03 A. H. Hoffner

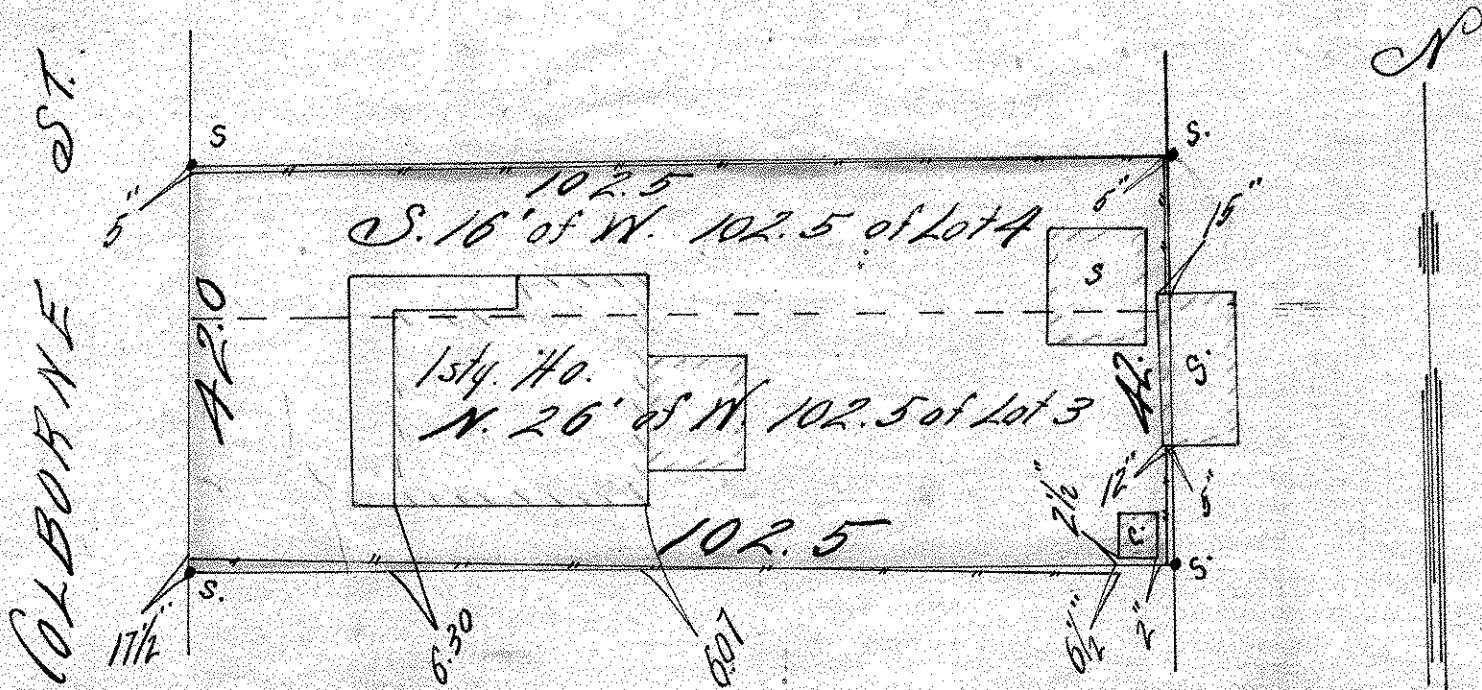

RECORDED ON

