

FROM THE OFFICE OF

CHARLES O. GEORGI COMPANY

2215 West County Road B

Saint Paul, Minnesota 55113

REGISTERED CIVIL ENGINEER AND LAND SURVEYOR

Certificate of Survey

I Hereby Certify that this plat shows a survey made by me of the property described on this plat, and that the corners are correctly placed as shown, and that all locations have been correctly shown.


Project No. Minn A-1-1
Parcel No. 88-C2
Area. 5,991 sq. ft. mo. l.

Surveyed For *Housing Authority*
Date *November 1973*
Scale *1" = 40'*

By *Charles O. Georgi*
REGISTERED LAND SURVEYOR

Description:

Lot 8 except the East 27 feet thereof,
and Lot 9, Block I, A.B. Wilgus Addition
to the City of Saint Paul, Ramsey
County, Minnesota.

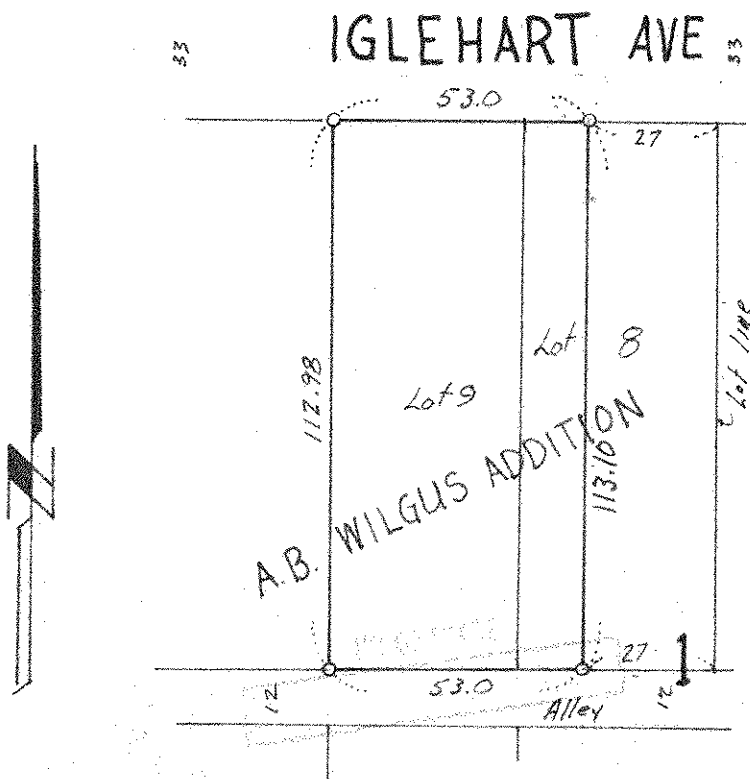

o denotes iron pipe monuments