


LOT 2 BLOCK 19 HAWKES SUB.  
OF WINSLOW'S ADD.  
SUT. Feb. 14<sup>th</sup> 1903 for Joe Shanoha  
20 ft. pr inch

GOODRICH 66 AVE.

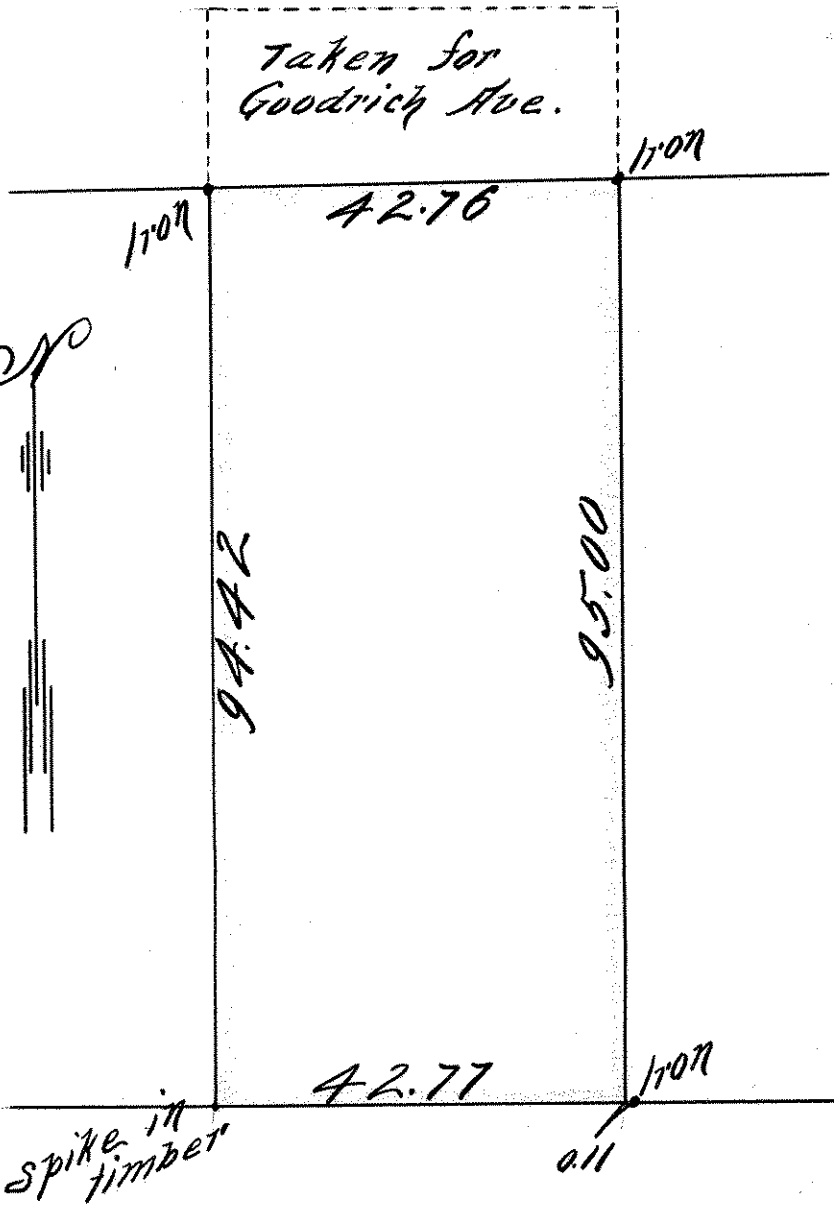

NO 0377432

