

LOT 2 HAWKES'S SUB. of BLK. 23.
WINSLOW'S ADD.

JOHN B. IRVINE, SURVEYOR.


ROOM. 508 GLOBE BLD'G.

SCALE 1 IN. = 20 FT.

ST PAUL MINN.

JUNE 5-05.

GOODHUE ST.

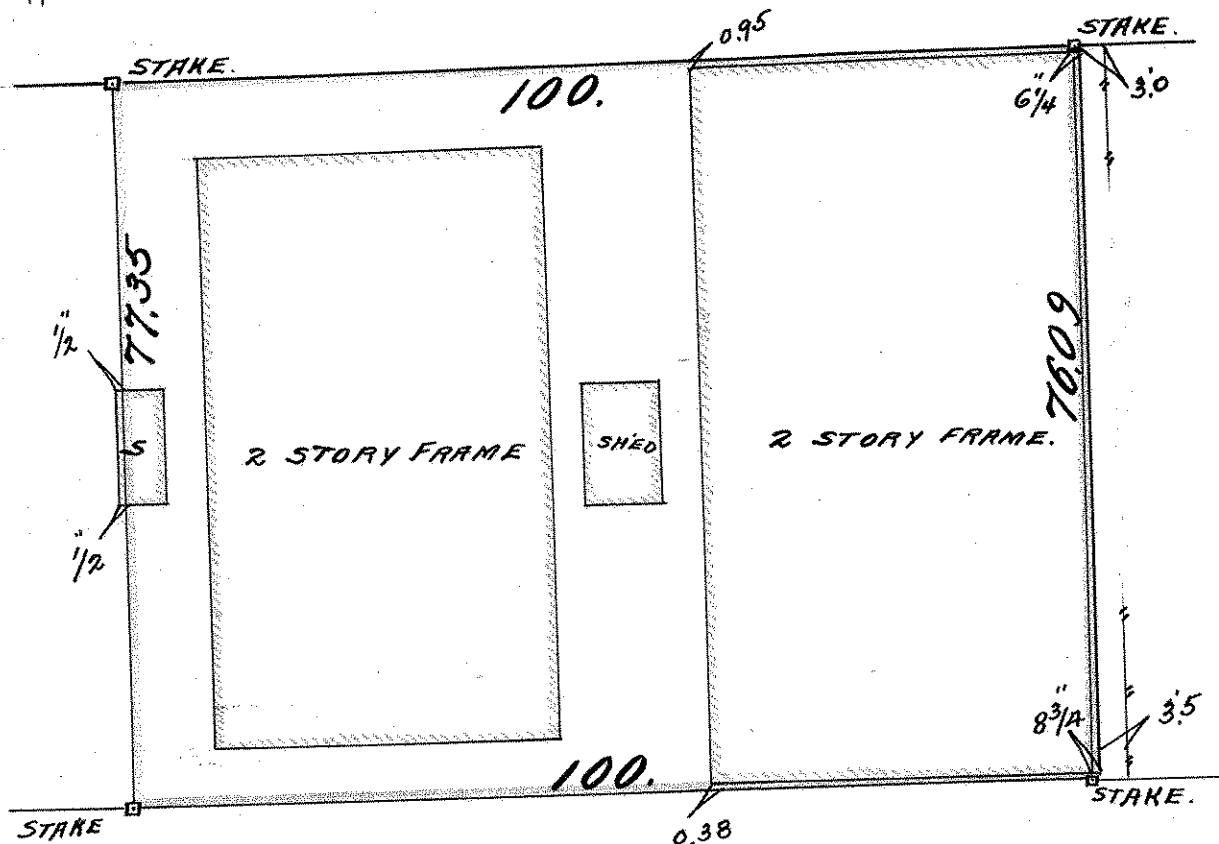

SUPERIOR ST.