


LOT 24 BLOCK 1
WINTER'S ADD.

20 Ft. pr inch
SUT. Aug. 16. 1902

CAPITOL AVE.

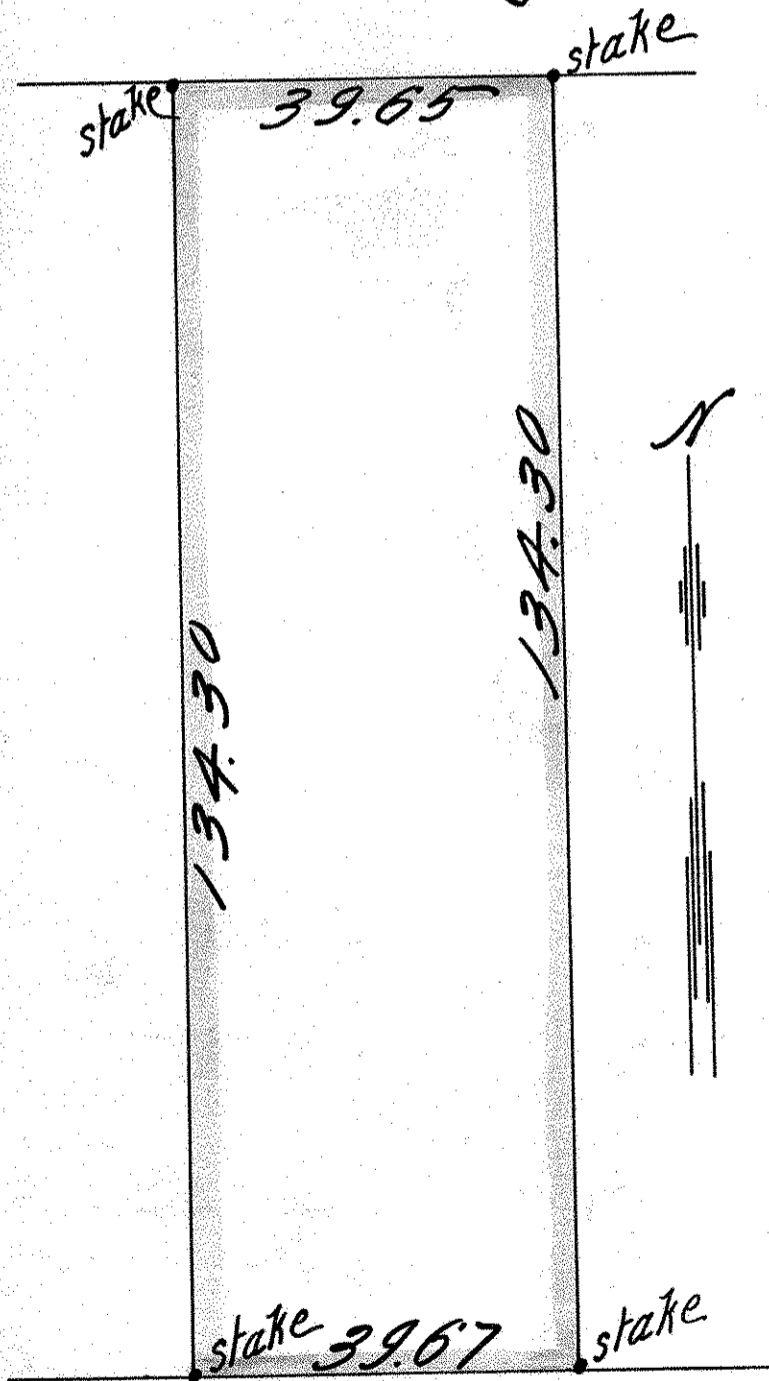

B. 47. P. 64.