


LOTS 13 & 18 BLOCK 5  
WINTER'S ADD.  
SUR. Oct. 21<sup>st</sup> 1902  
scale 20 ft. pr in.

HUBBARD ST.

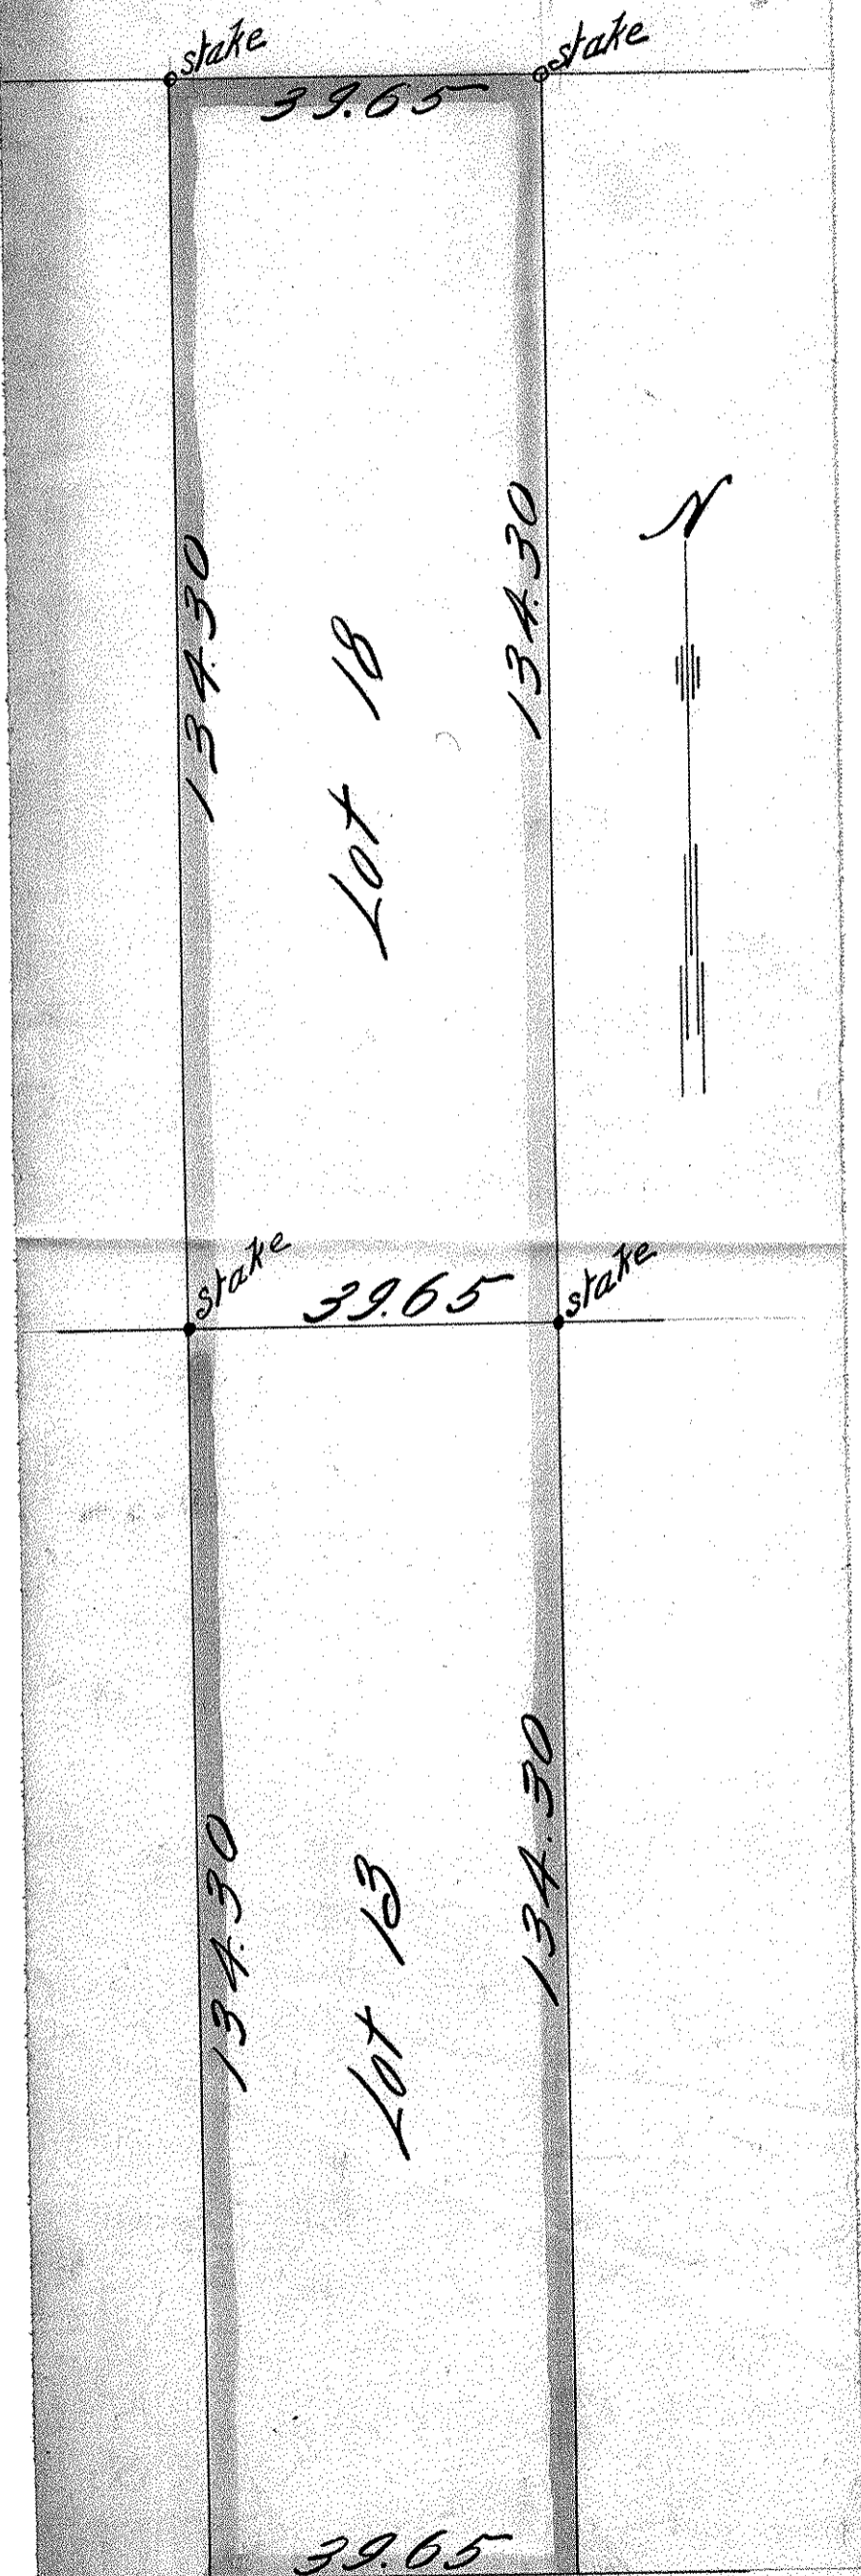

SEMINARY ST.  
353. P. 17