

LOTS 2, 3, 4, 5 BLOCK 5

WINTER'S ADD.


JOHN B. IRVINE. SURVEYOR.

416 GLOBE BLDG.

ST PAUL MINN

OCT. 14-07

SCALE 20ft. per inch.

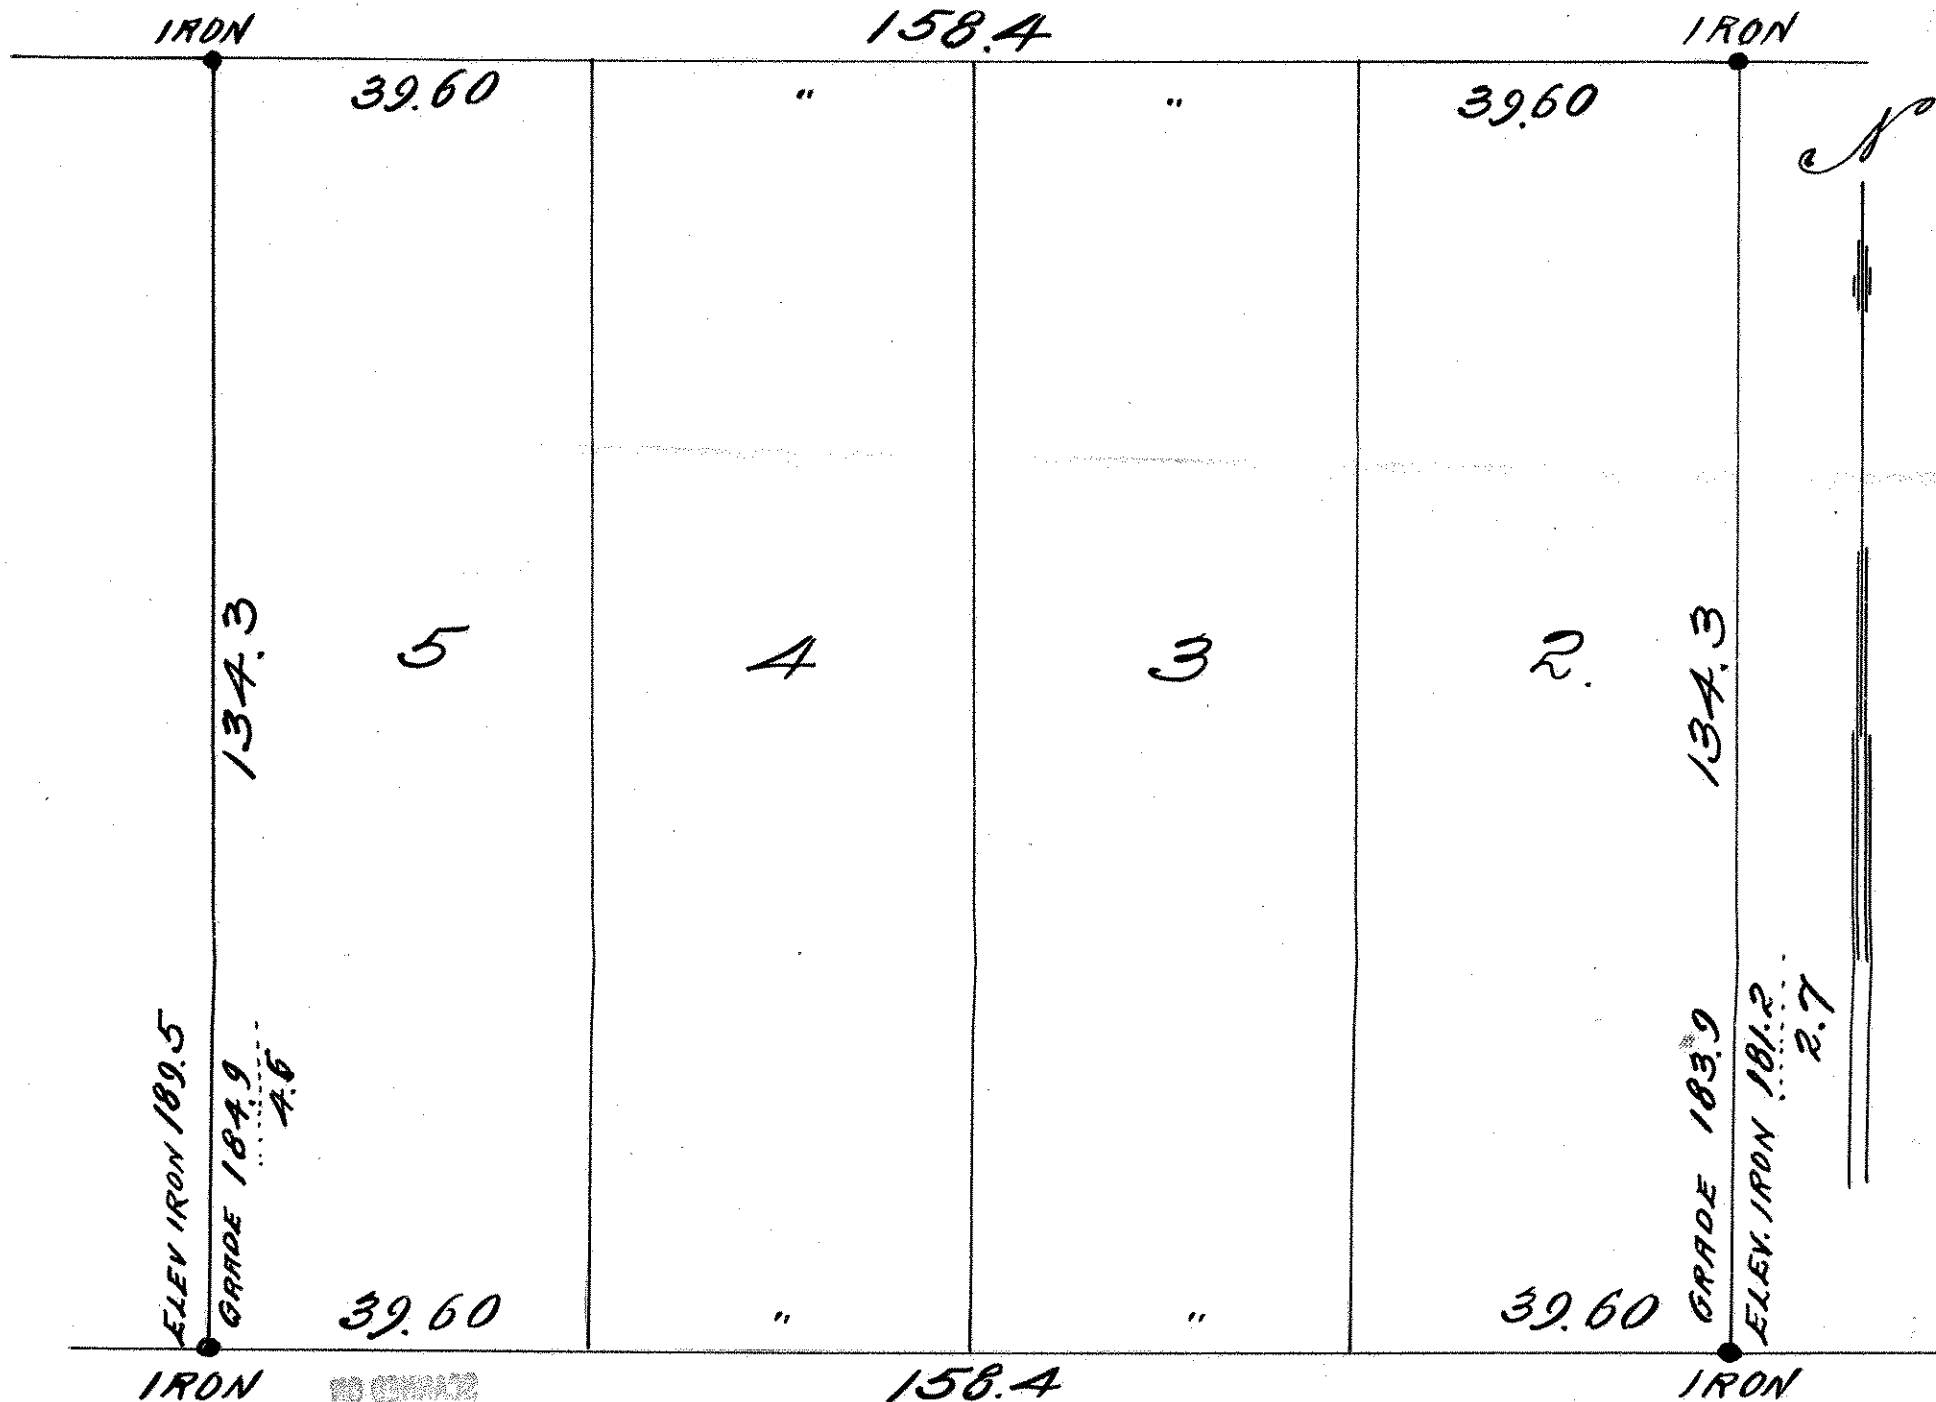

IRON

TO CORNER

158.4

IRON

SEMINARY ST.