

LOTS 1, 2, 3, BLOCK 7.
WINTER'S ADD.

JOHN B. IRVINE, SURVEYOR.


408 GLOBE BLDG.

ST. PAUL, MINN.

MAY. 21-1915

Scale 40 ft. per inch.

N

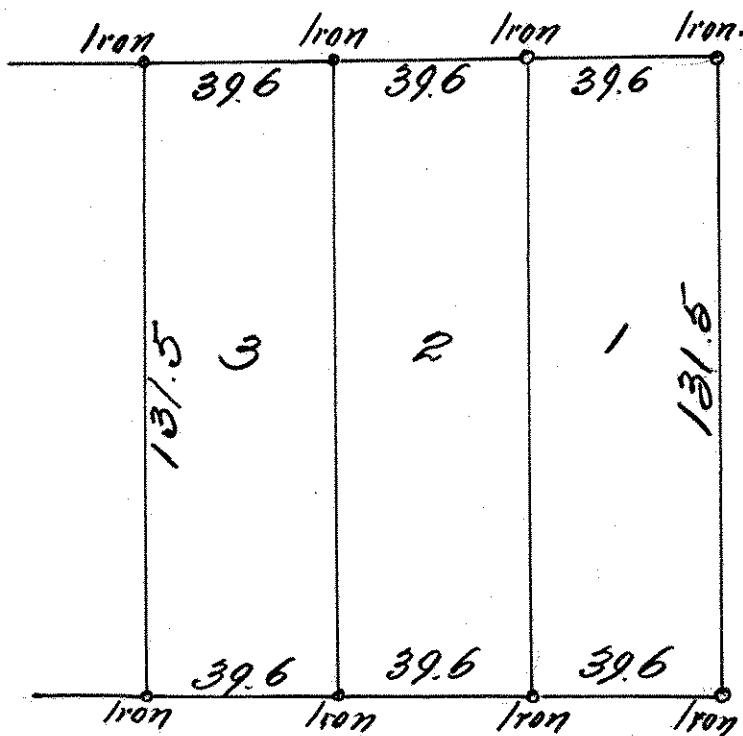

IRON MARKER

100' WINTER'S ADD ST.