

WINTER'S ADD.

SURVEY OF


LOTS 1 TO 9,

MAR., 9, 1917.

BLK. 17.

J. B. IRVINE  
SURY.

SCALE 1" = 30'

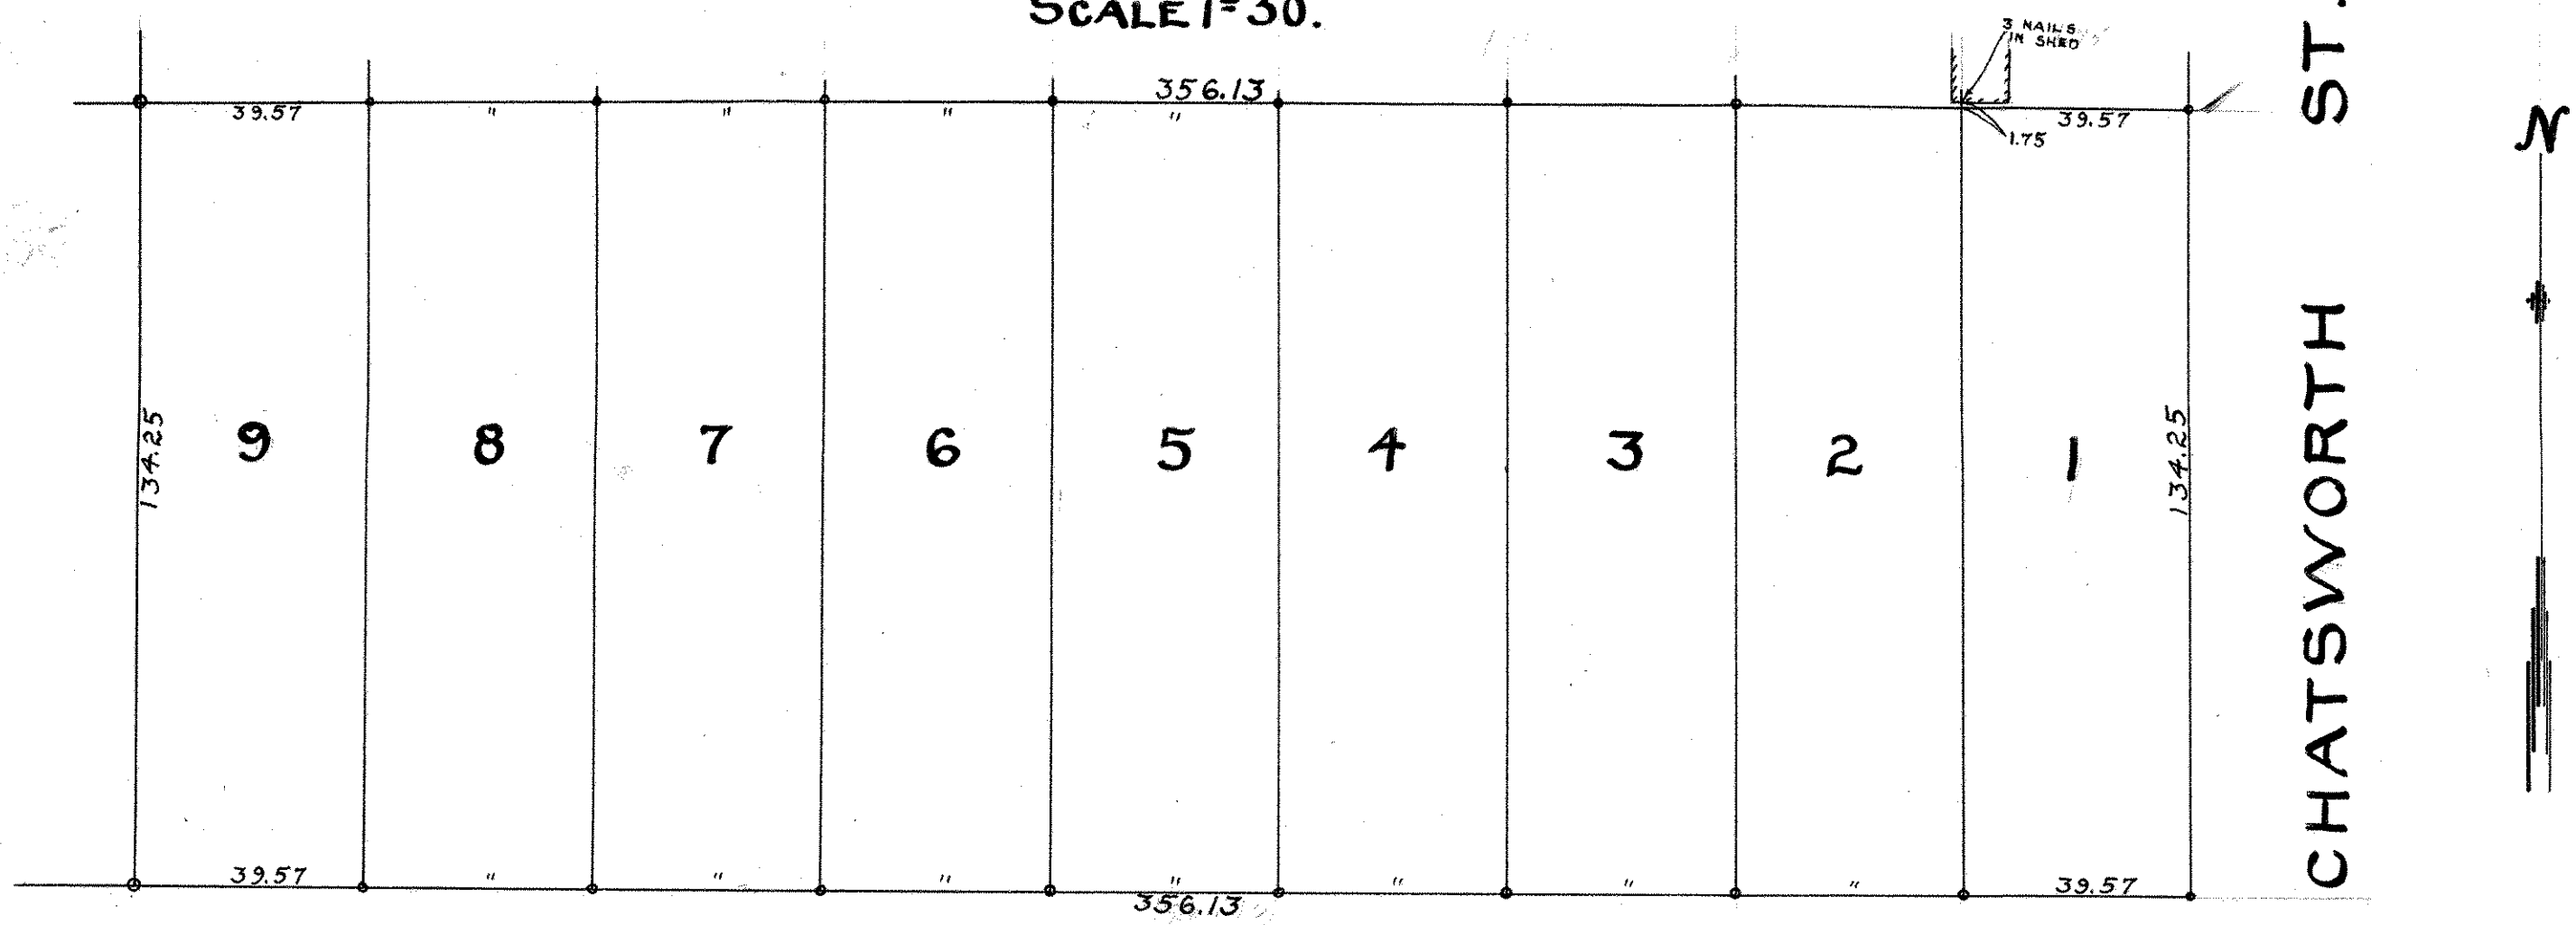

CHATSWORTH ST.

SEMINARY

ST.

