


LOT 15. BLOCK 8.  
 WOODLAND PARK ADD.  
 JOHN B. IRVINE SURVEYOR.  
 ROOM. 508 GLOBE BLD'G.  
 ST. PAUL MINN  
 SCALE 20' = 1" APRIL 27-05.

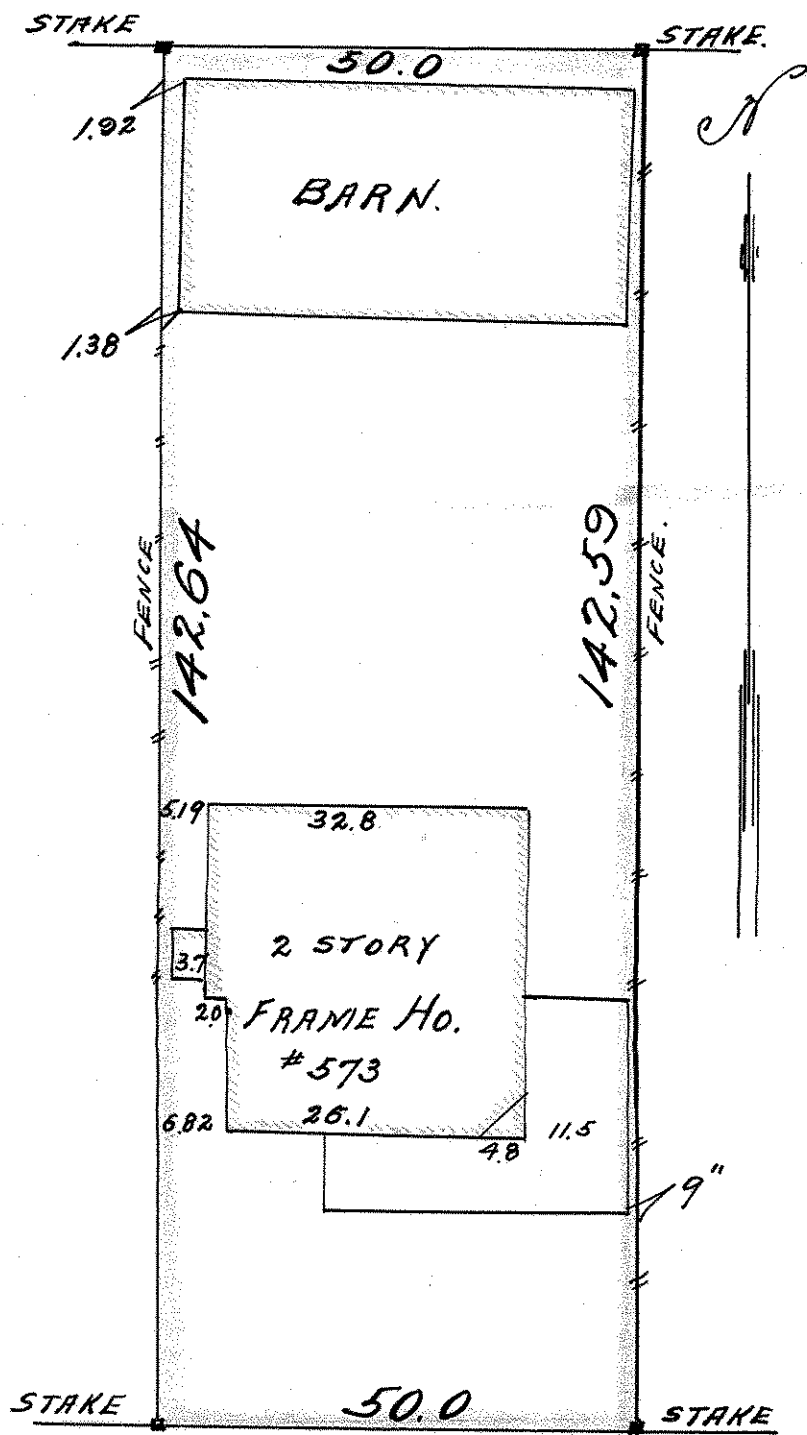

ASHLAND AVE.