

NORTH 100ft. LOT 2 BLK. 8.

WOODLAND PARK.

JOHN B. IRVINE. SURVEYOR.


416 GLOBE BLD'G.

ST PAUL MINN.

SEPT. 21-07

SCALE 20ft per inch.

LAUREL AVE.

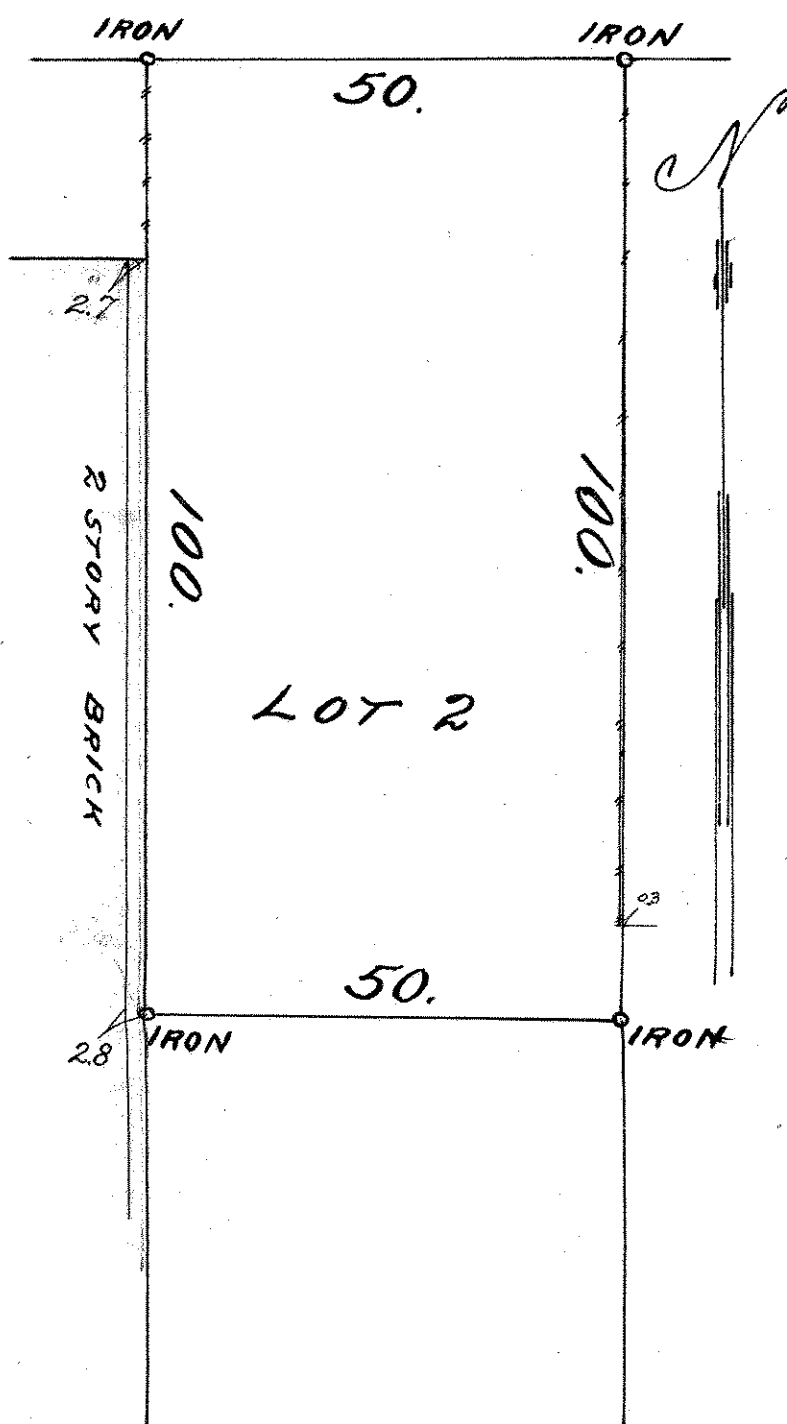

ALLEY 15