


LOTS 16 & 17 BLK. 8
WOODLAND PARK
ADD.

JOHN B. IRVINE SURVEYOR.
416 GLOBE BLDG.
ST PAUL MINN.

SCALE 1 IN. = 20 FT.

OCT. 27-06.

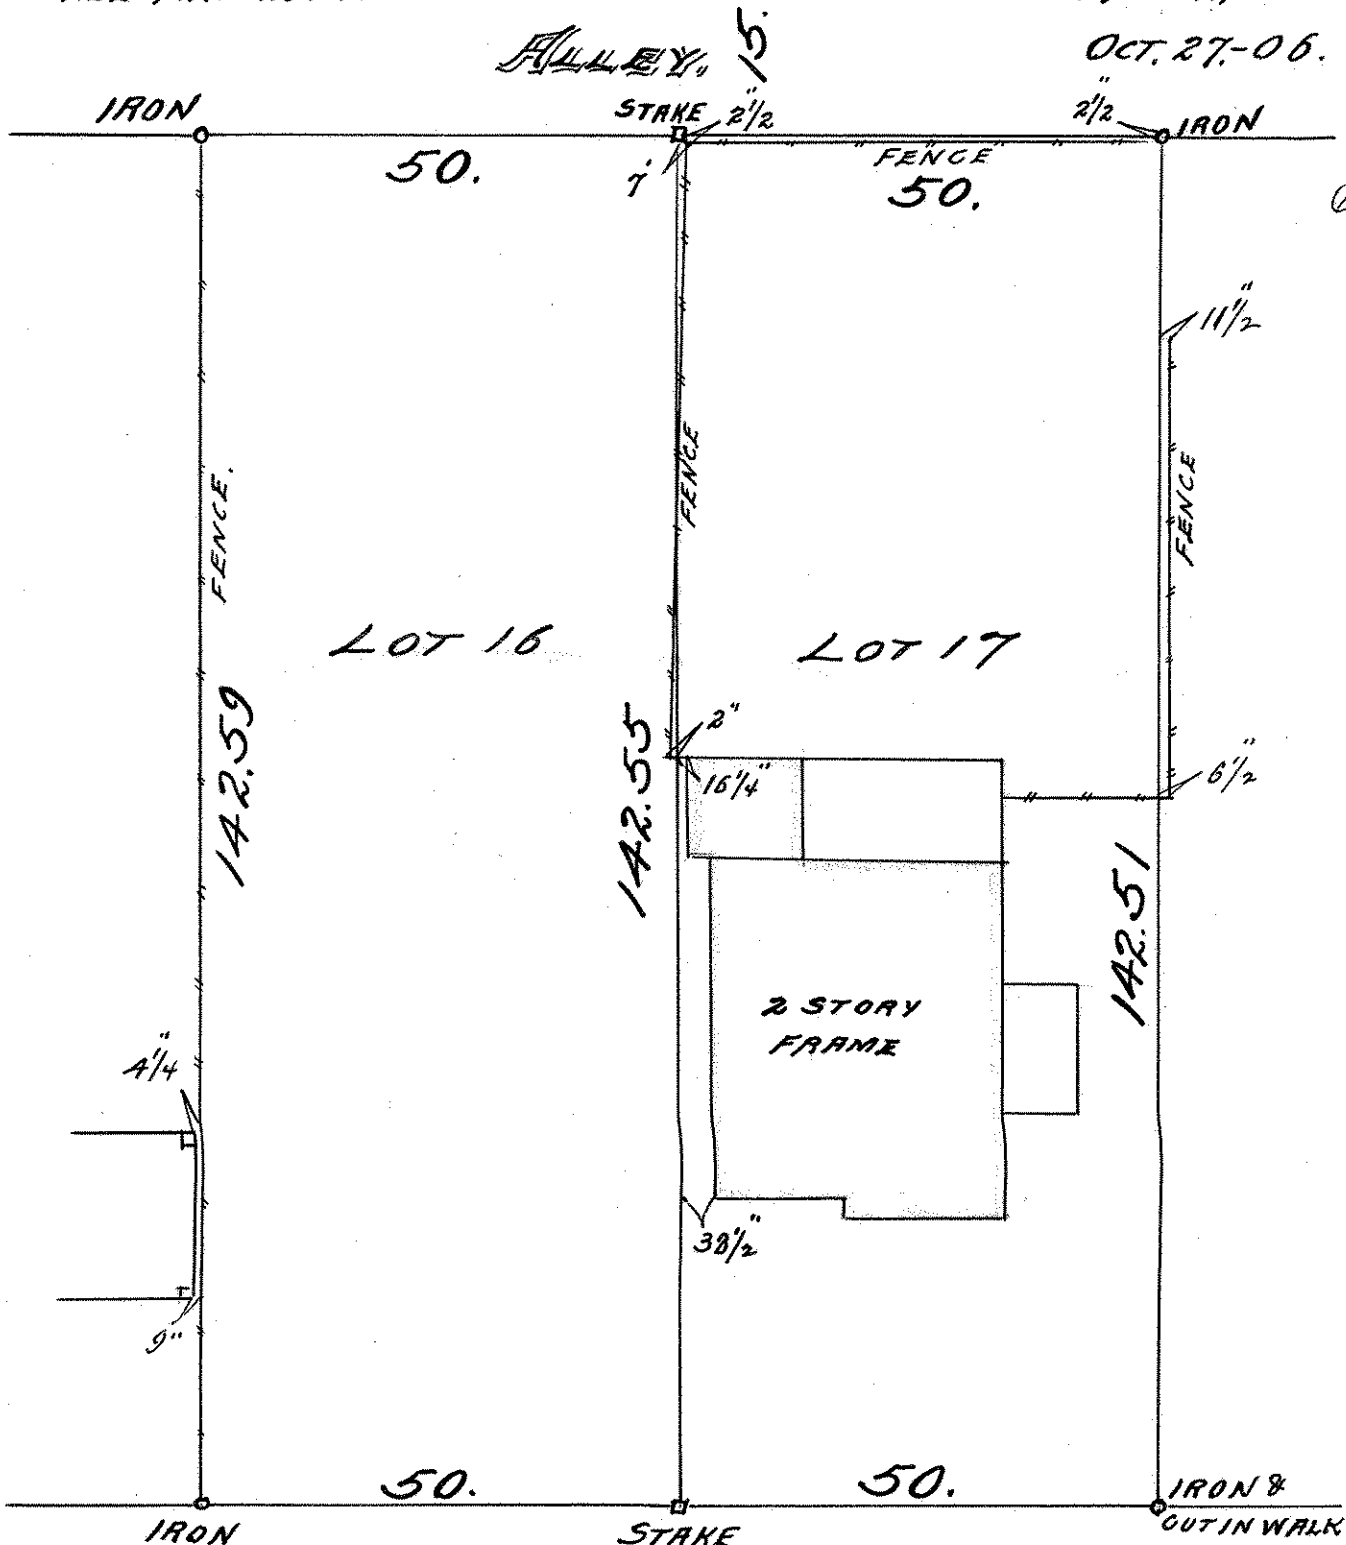

ASHLAND AVE.