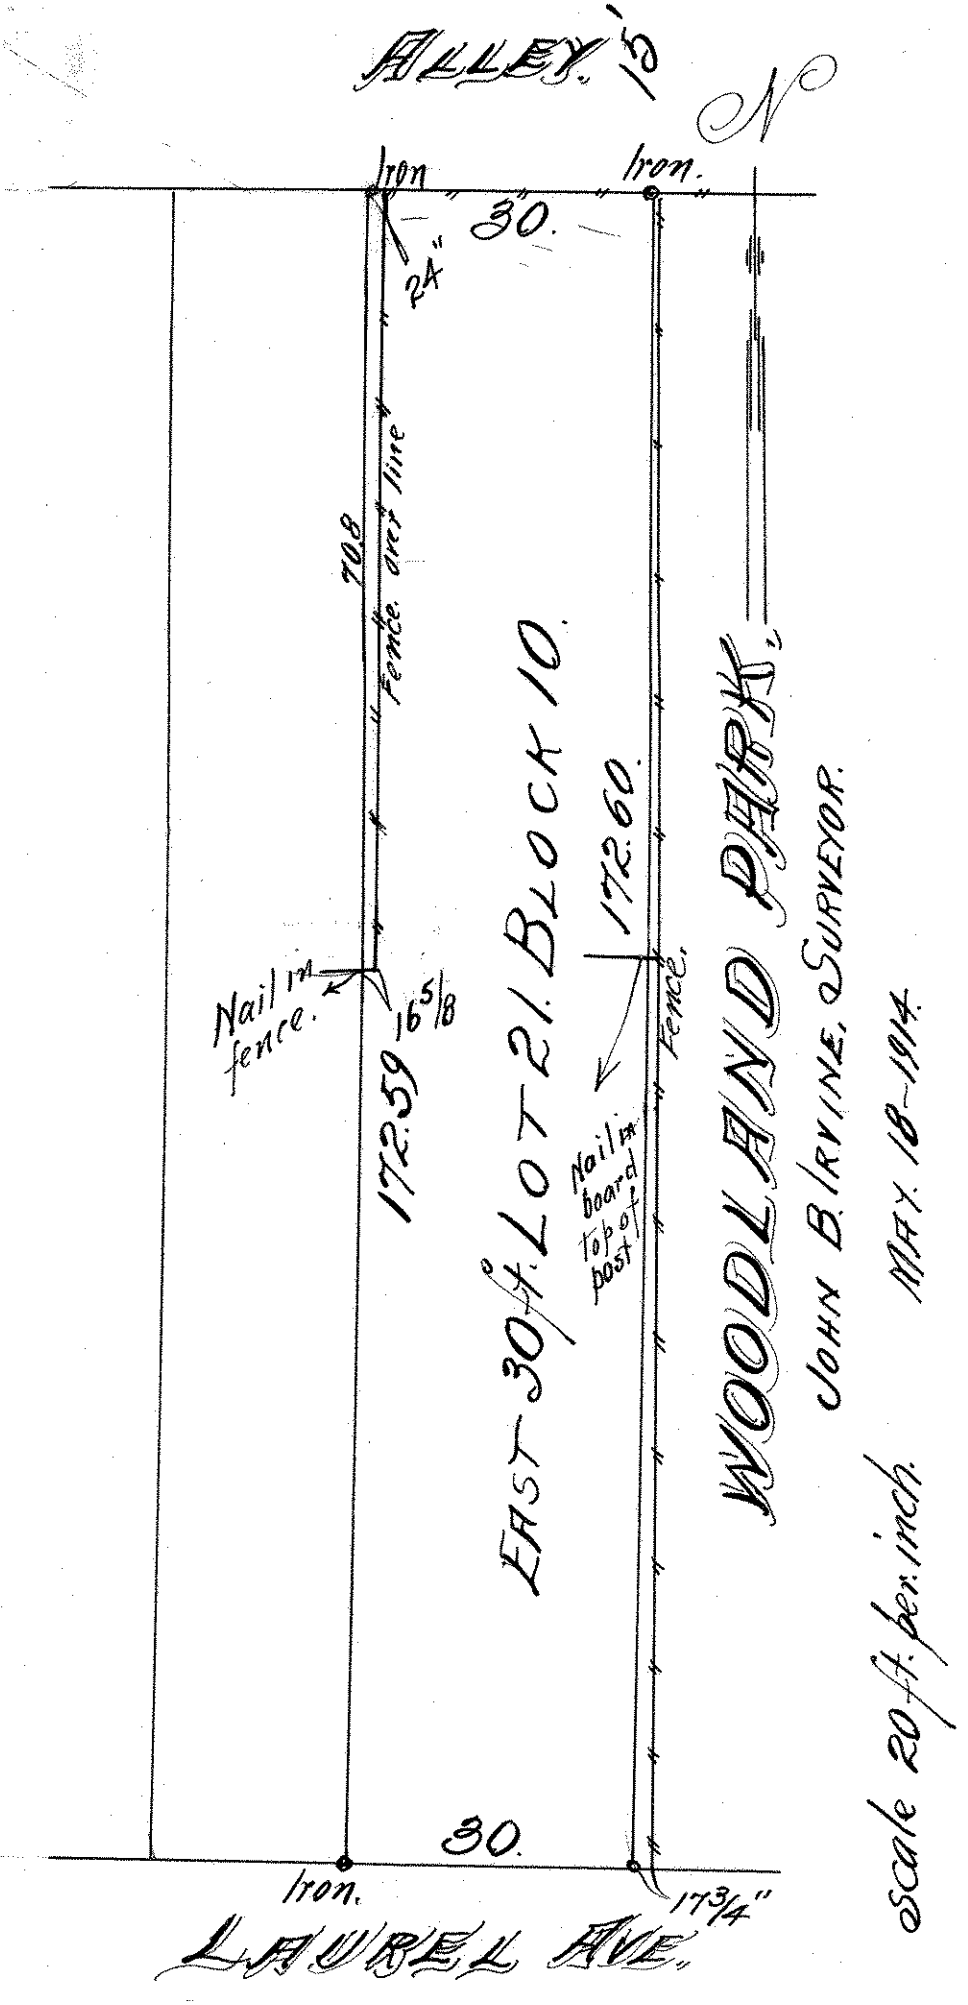
ALLEY. 15'
N
Iron.
Iron.
30.
24"
Fence. over line
70.8
EAST 30 ft. LOT 21. BLOCK 10.
172.60.
Nail in fence.
16 5/8
172.59
Fence.
Nail in board top of post
WOODLAND PARK.
JOHN B. IRVINE, SURVEYOR.
MAY. 18-1914.
scale 20 ft. per. inch.
30.
Iron.
173 3/4"
LAUREL AVE.